

UNITED STATES  
DEPARTMENT OF THE INTERIOR  
BUREAU OF LAND MANAGEMENT

**RECEIVED**  
SEP 23 1983  
WATER RESOURCES DEPT.  
SALEM, OREGON

SECTION

3


NE 1/4 NE 1/4

# Oregon State Water Filings

TOWNSHIP 38S., RANGE 2E., W. M.

Application No. R-66707, 66708

Permit No. R 9255 48170

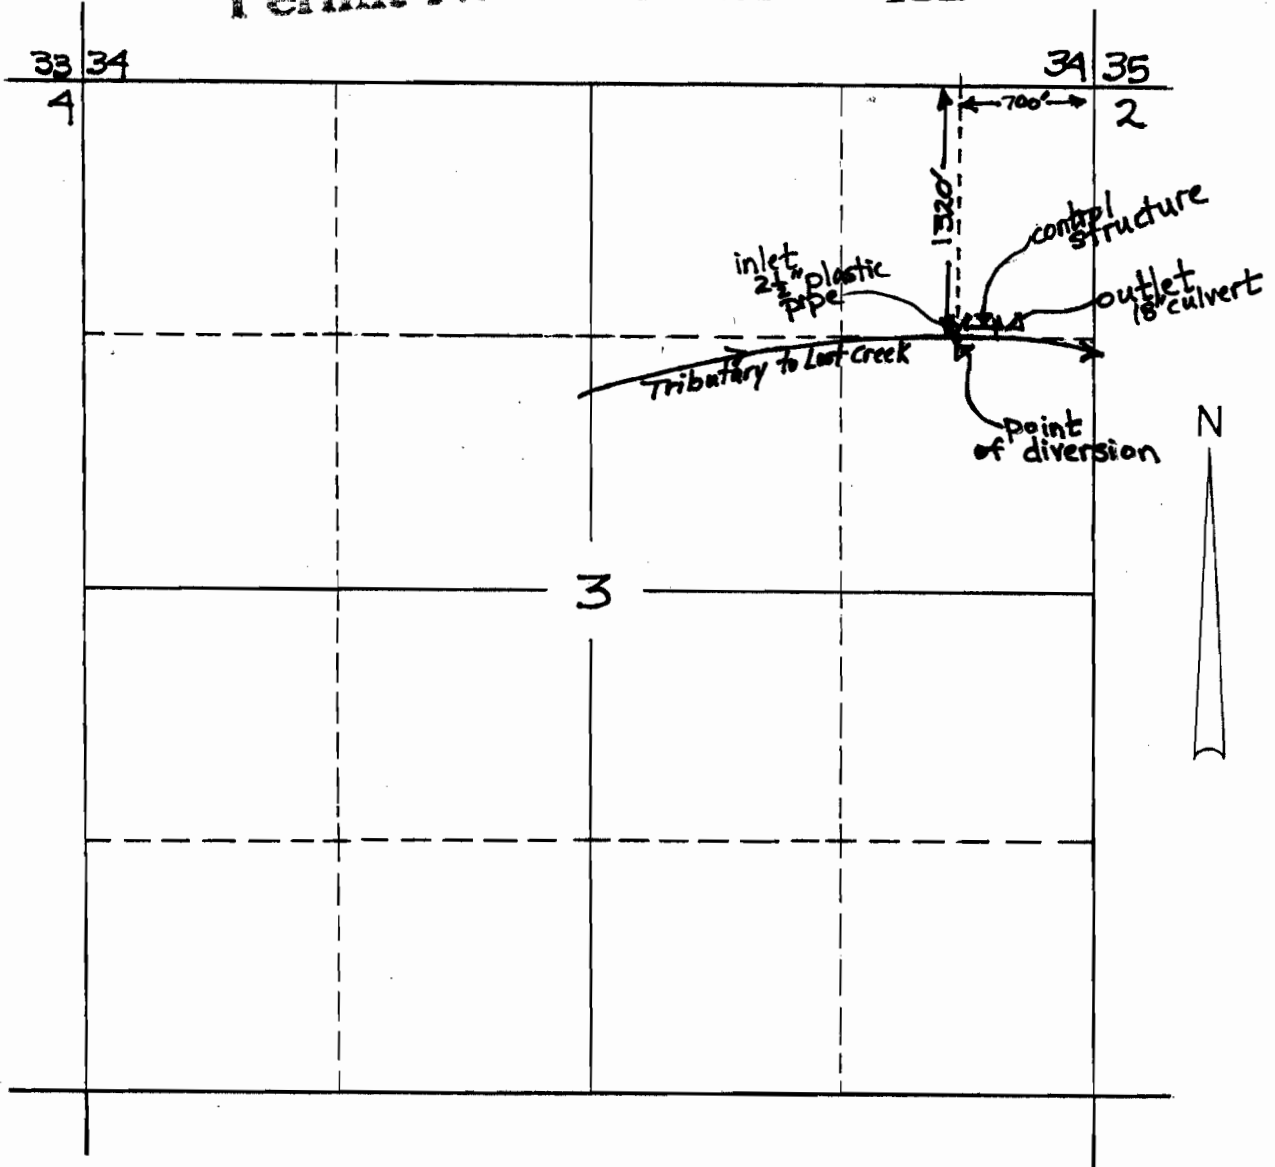

SCALE : 1" = 1000'