


Permit: S 48184
Volume: 1
Strm: ROGUE R
Trib: PACIFIC OCEAN
Priority: 10/03/83

T. 36 S., R. 5 W., W. M.

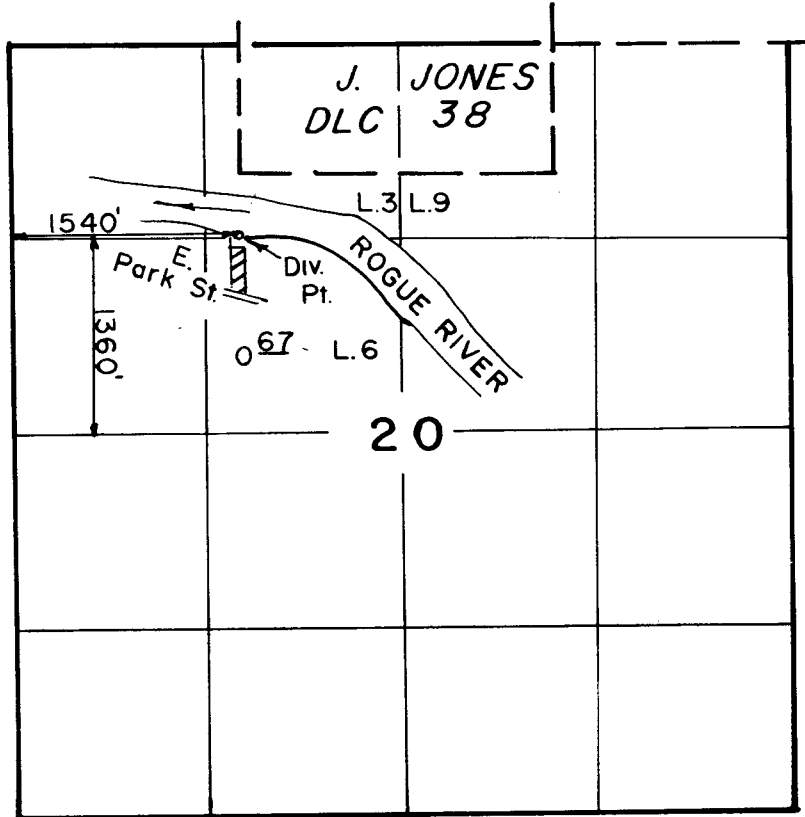

Scale: 1" = 1320'

RECEIVED
AUG 31 1990
WM. DIST. 14
GRANTS PASS, ORE.

FINAL PROOF SURVEY
UNDER

Application No. 67322 Permit No. 48184...
IN NAME OF

.....ROBERT M. THOMPSON.....

Surveyed AUG...6.. 1987., by B...S...JAMES.....