


T. 10 S, R. 5 E, W. M., Section 12, Subd. NW 1/4 NW 1/4

Mapped by H.G. White

Scale: 16 inches = 1 mile.

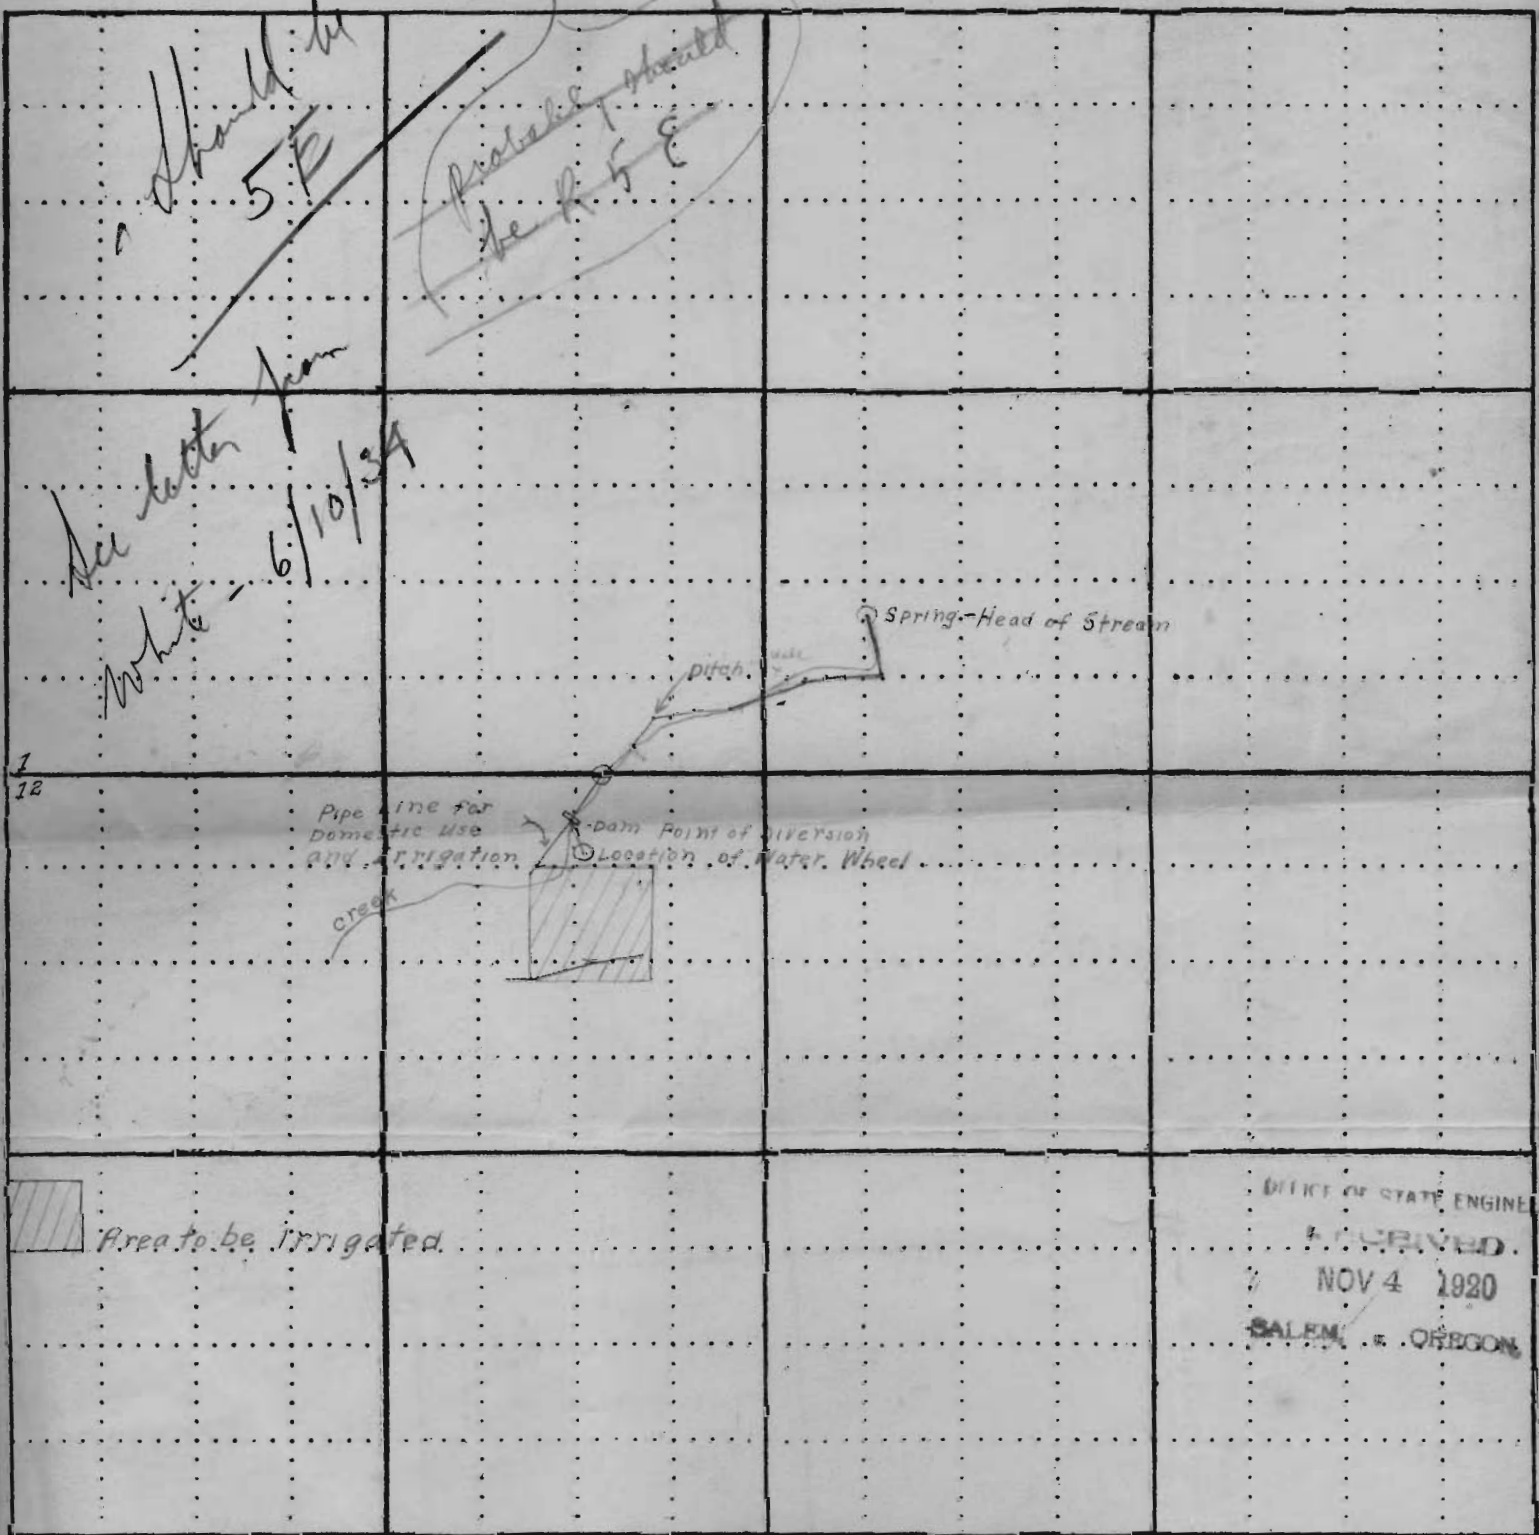

27  
11 12

DEPT. OF STATE ENGINE  
 RECEIVED  
 NOV 4 1920  
 SALEM, OREGON

Application No. 7403  
 Permit No. 4828  
 Cert. No. 3958