


Permit: S 48287
Volume: 6A
S Strm: JACKSON CR
Trib: APPLGATE R
Priority: 1/11/84

T.37S. R.6W. W.M.

37-6-15

RECEIVED

JAN 25 1984
WATER RESOURCES DEPT.
SALEM, OREGON

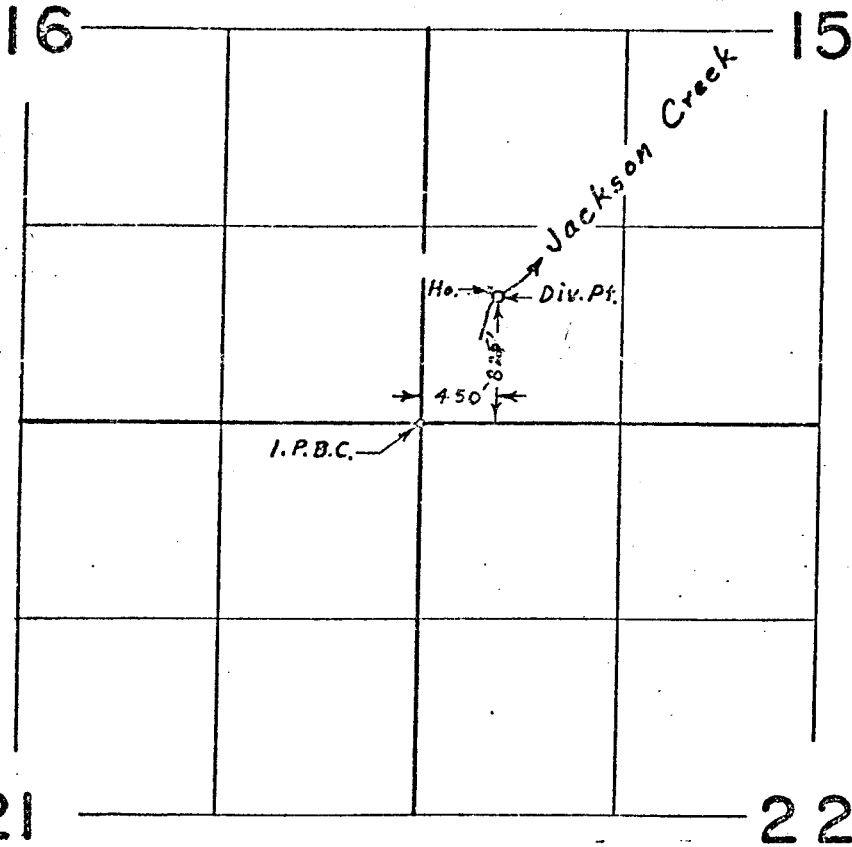

RECEIVED

MAR 27 1984

WATER DIST 14
GRANT'S PASS, ORE.

Application No. 67996
Permit No. 48287

~~FINAL PROOF SURVEY~~
~~UNDER~~




