


T. 36 S., R. 5 W., W. M.

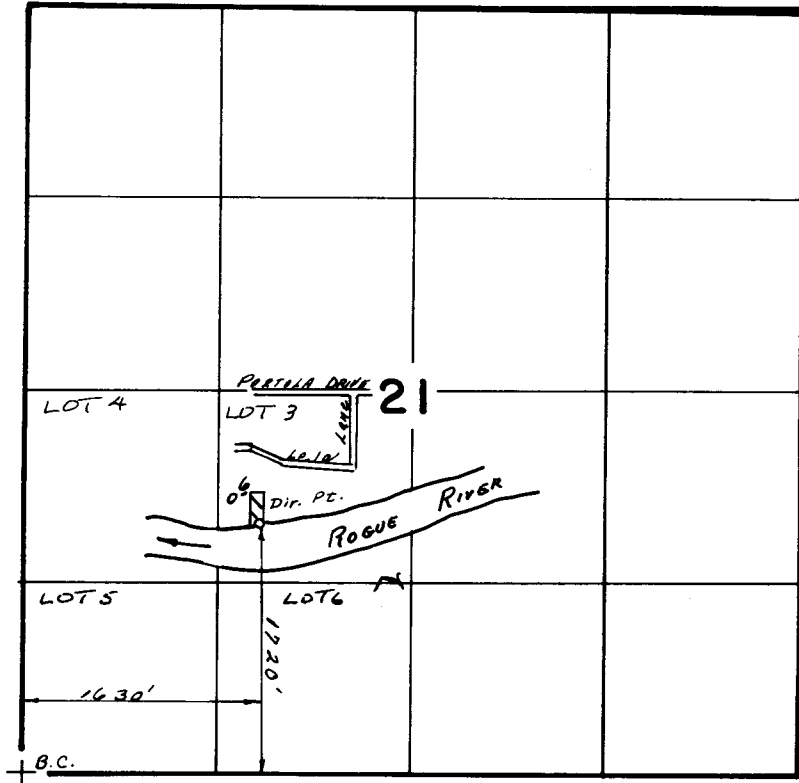

Scale: 1" = 1320'



RECEIVED
 AUG 31 1990
 WY. DIST. 14
 GRANTS, MASS. ORE.

FINAL PROOF SURVEY
 UNDER

Application No. 67987. Permit No. 48307...
 IN NAME OF

.....RICHARD..... TRESEMER.....

Surveyed AUG...3... 1987, by B:..S. JAMES...