


Township # 9 South Range 45 East Willamette Meridian.

R. NORTH R.

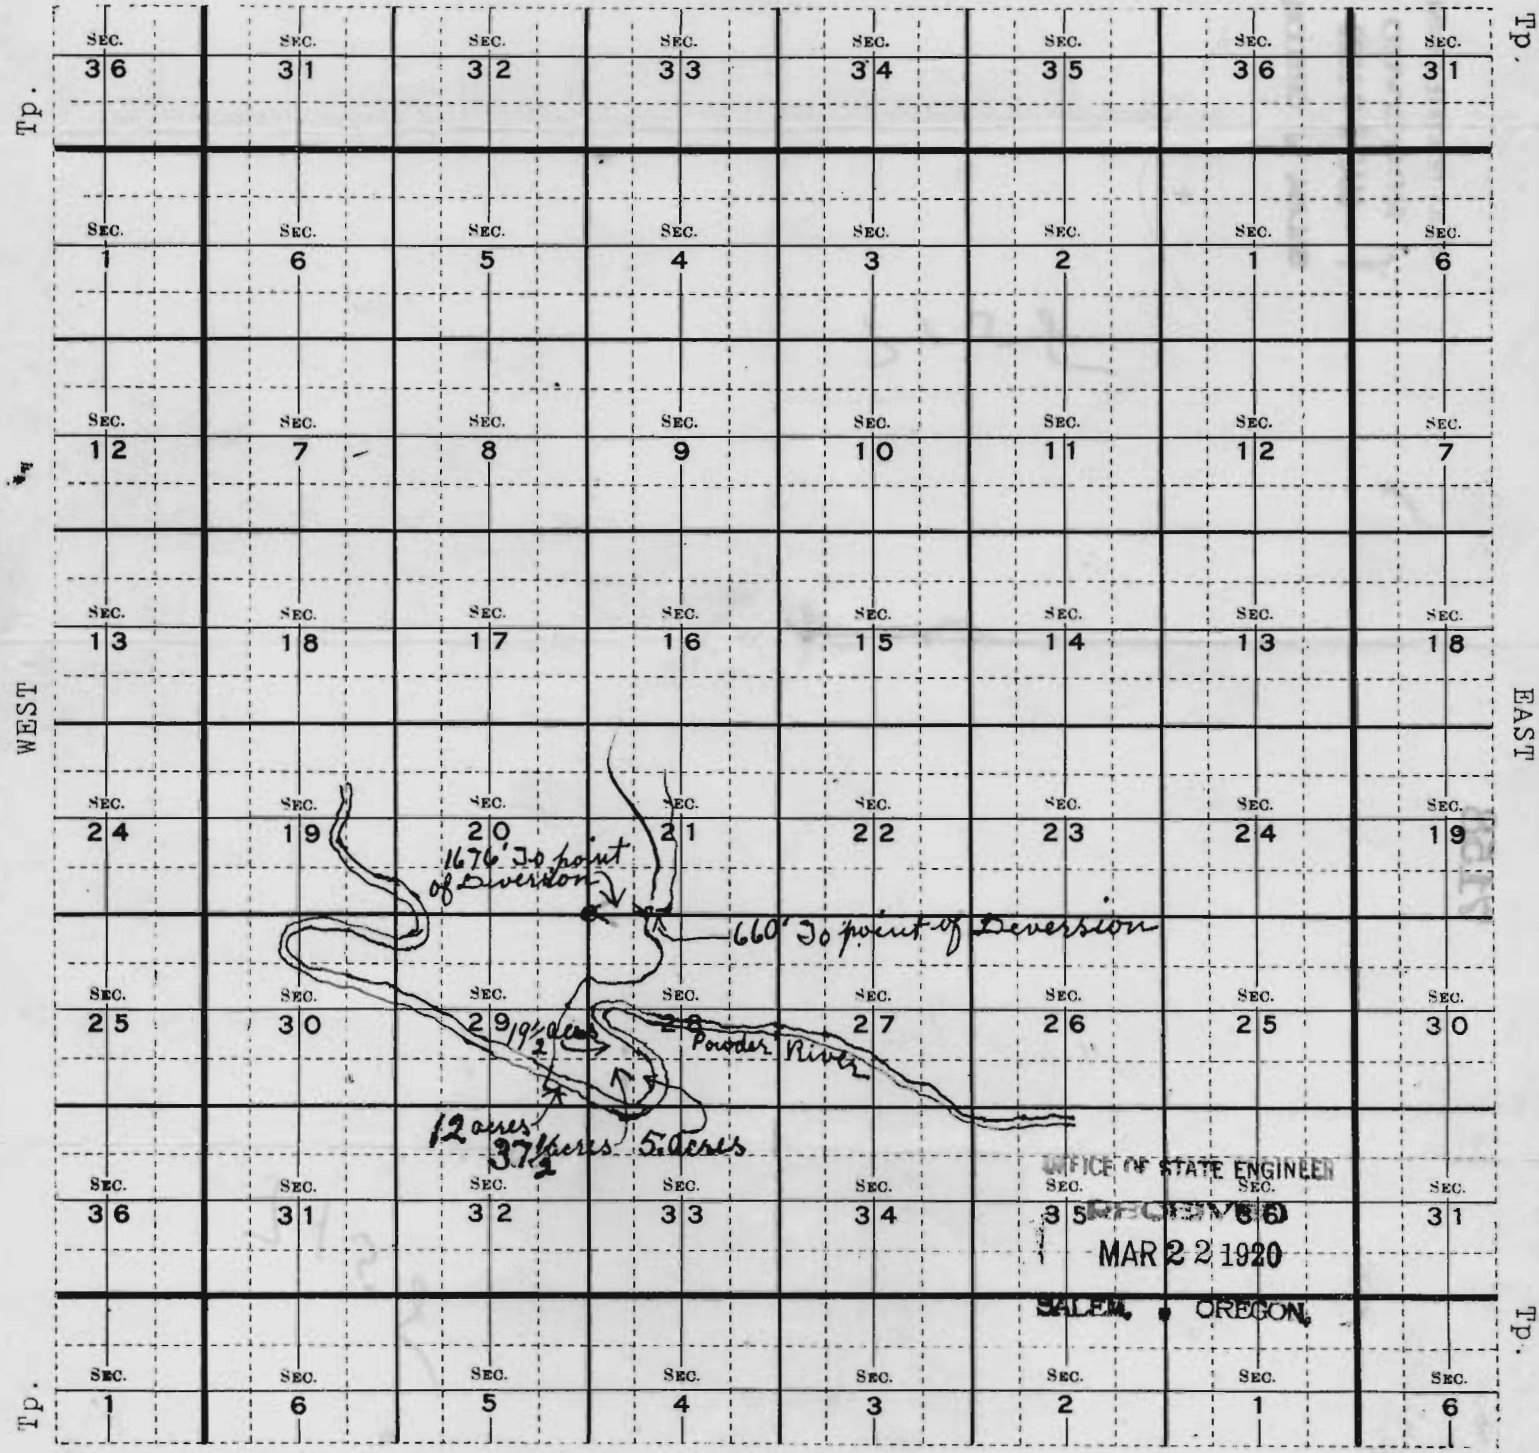

Plot P4 SOUTH COYOTE PRINT J-141

Application No. 7158
Permit No. 4838