
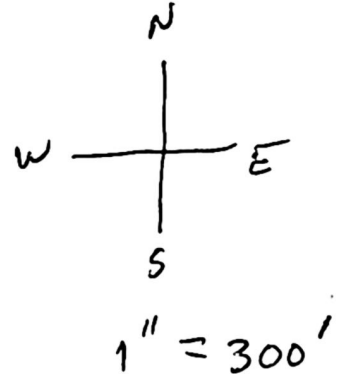


Application No. ⁶⁵⁶¹⁵ 48430
Permit No.

PAUL PIERSON
P.O. BOX 59
BROOKINGS, ORE
97415

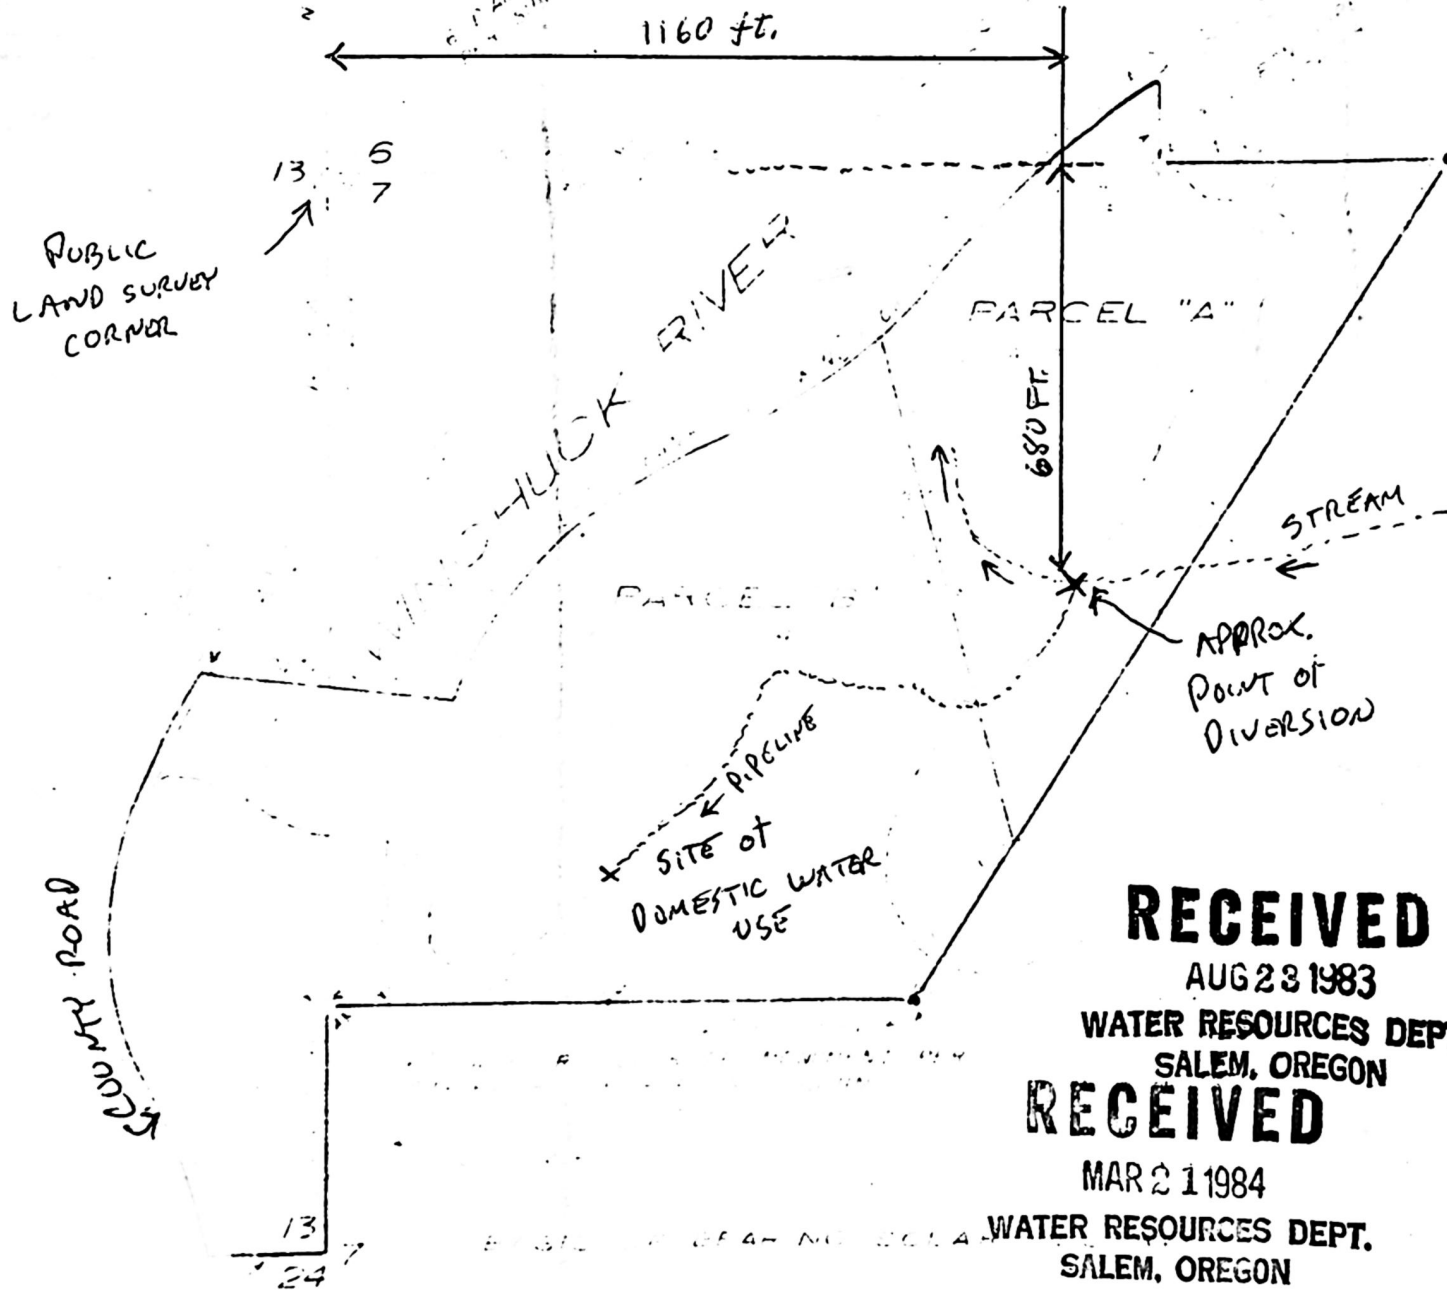

RECEIVED
AUG 23 1983
WATER RESOURCES DEPT.
SALEM, OREGON

RECEIVED
MAR 21 1984
WATER RESOURCES DEPT.
SALEM, OREGON

SECTION 7
~~SECTIONS 6 & 7~~ THIS, R12W
~~SECTION 13~~ THIS, R13W
WM
CURRY COUNTY, ORE.