


T. 37 S., R. 5 W., W. M.

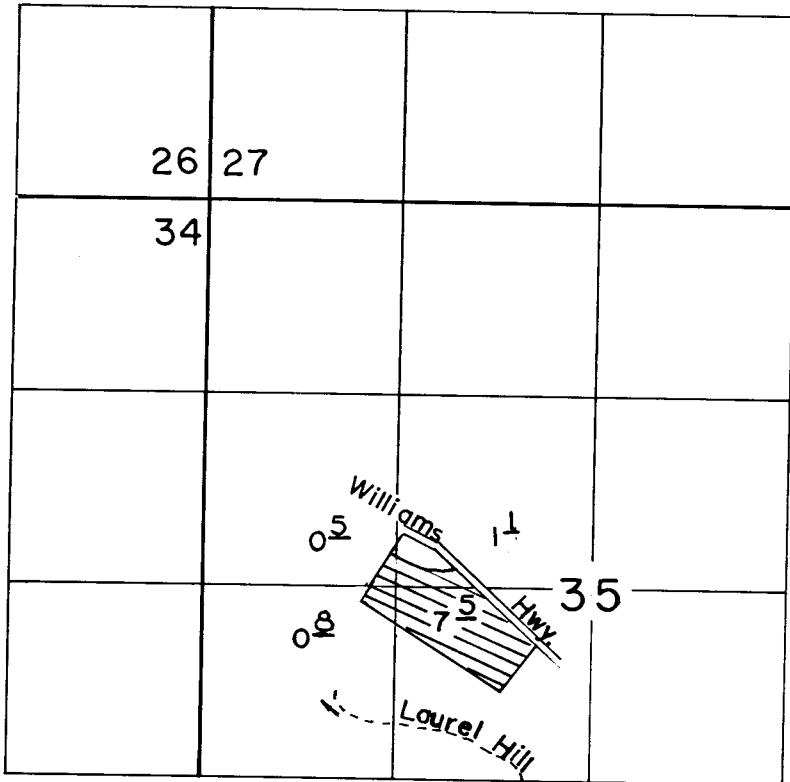

Scale: 1" = 1320'

Laurel Hill Div. Pt. :

SW 1/4 NE 1/4 Sec. 1, T.38S., R.5W., W.M.
125' N. & 500' E. from C₁ cor. Sec. 1

RECEIVED

MAR 28 1991

WM. DIST. 14
GRANTS PASS, ORE.

FINAL PROOF SURVEY UNDER

Application No. 61094 Permit No. 48449
IN NAME OF

..... LYLE WOODCOCK

Surveyed AUG. 23. 19.88., by B.S. JAMES.....

41033-17-110R

LMS
4/90