


Application No. 60799

Permit No. 48499

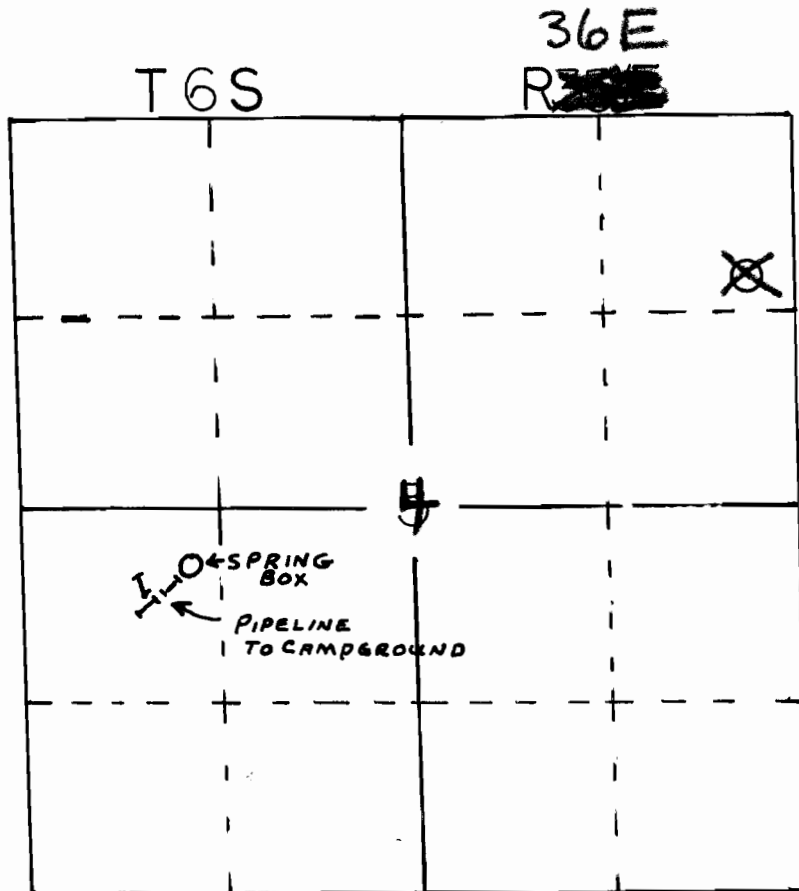

**RECEIVED**

JUL 11 1983

WATER RESOURCES DEPT.  
SALEM, OREGON

JUL 11 1983

WATER RESOURCES DEPT.  
SALEM, OREGON