


Section 35 T.16S. R.3W.W.M.

LANE COUNTY

SCALE 1"=400'

See Map 16 03 26

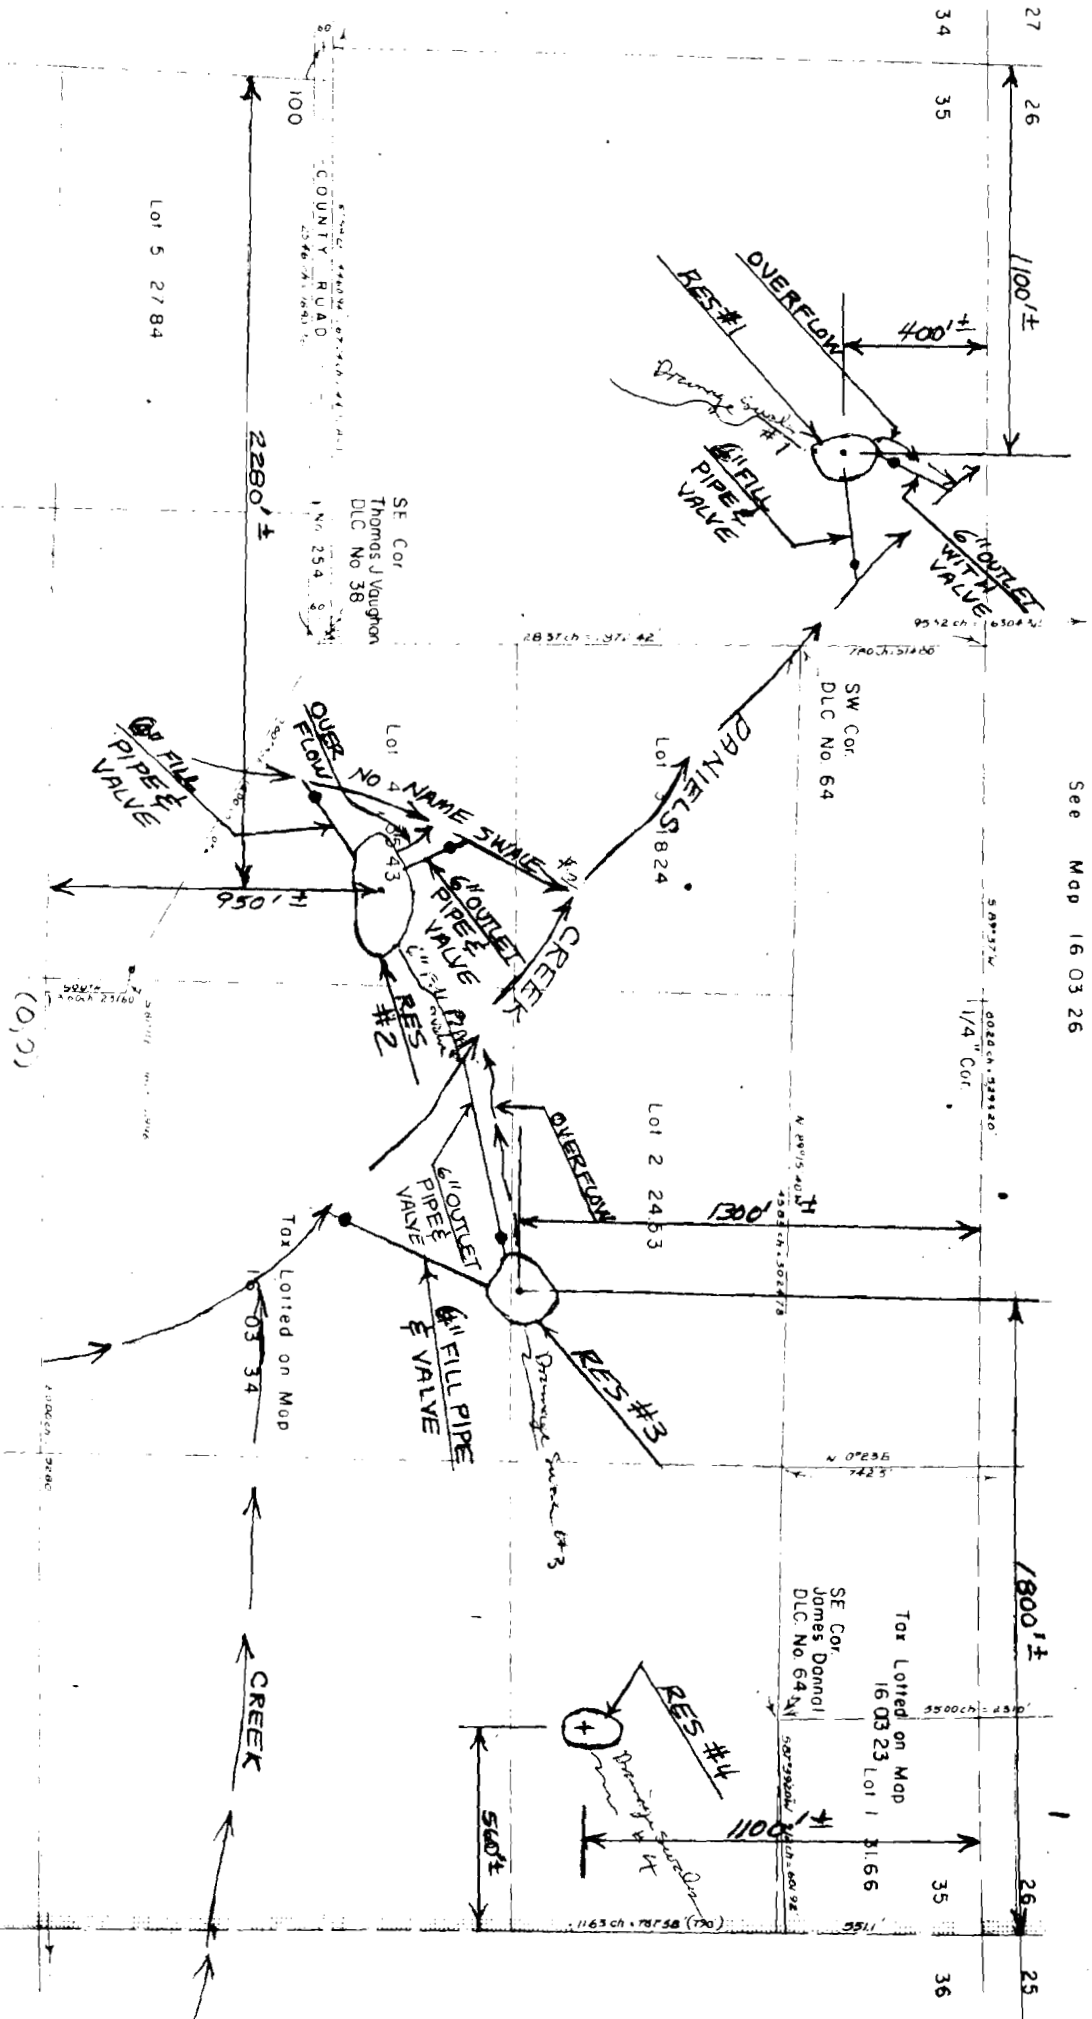

See Map 16 03 34

COORD. OF OUTLET PIPES
FROM CENTER SECTION

COORD. OF FILL PIPES
FROM CENTER SECTION

004-30

See Map 16 03 36

RESERVOIR #5
CORD. OF OUTLET PIPE
FROM NW COR

