



MAP
Showing Location
of
Appropriation of Water
for
Domestic and irrigation purposes
by
H. E. Blackwell.

Twp 5 South Range 7 West.

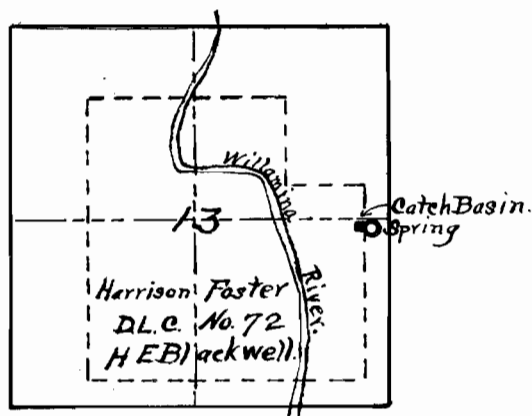

Map Showing Main Water Pipe Line. - Scale 200 ft = 1 in.

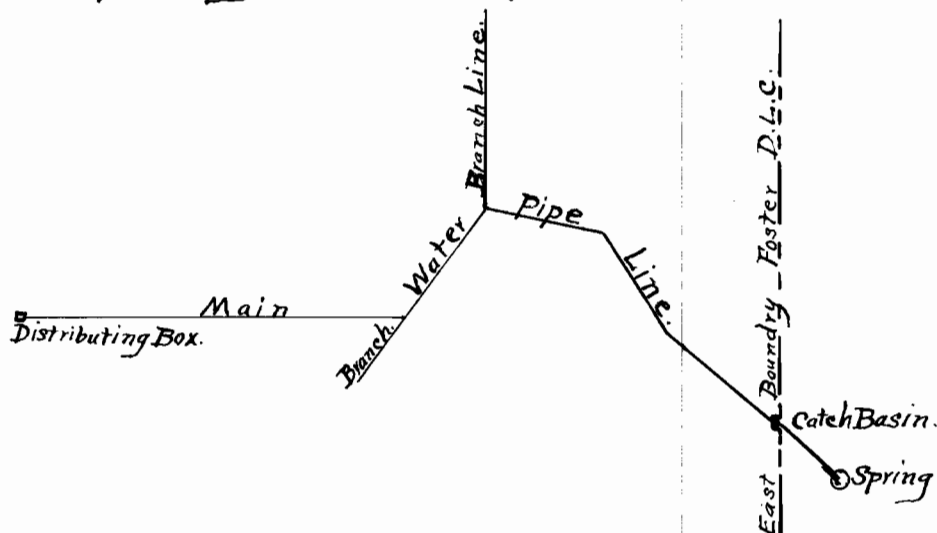

Spring is located 66 ft. East of a point on the East boundary of Harrison Foster D.L.C. No. 72, 623.00 ft. South of the North and most Easterly corner of said claim.
A 2 in water pipe runs from Spring N 51° 48' W 87 ft. to Concrete Catch Basin.

Main water pipeline from Catch Basin as follows:

N 51° 08' W 155.00 ft.

N 32° 33' W 120.12 "

N 79° 26' W 120.78 Branch Pipe runs 200 ft. N.

S 35° 02' W 140.58 " - continues 75 ft. to house.

S 88° 47' W 400.00 ft. to Distributing Box
for irrigating a portion of the NE ¼ of SE ¼ of Section 13,
T5S, R7W, W.M. Oregon.

I R. V. Stockton of Sheridan, Oregon, do hereby certify that this map was made from the notes taken during an actual survey made by me on the 31st day of August and the 1st day of September 1910, and that it correctly represents the work described in the accompanying application together with the location of streams in the immediate vicinity.

R. V. Stockton
Surveyor.

536
488