


T. 1 N

R. 42 E

W.M.

Mer.

525

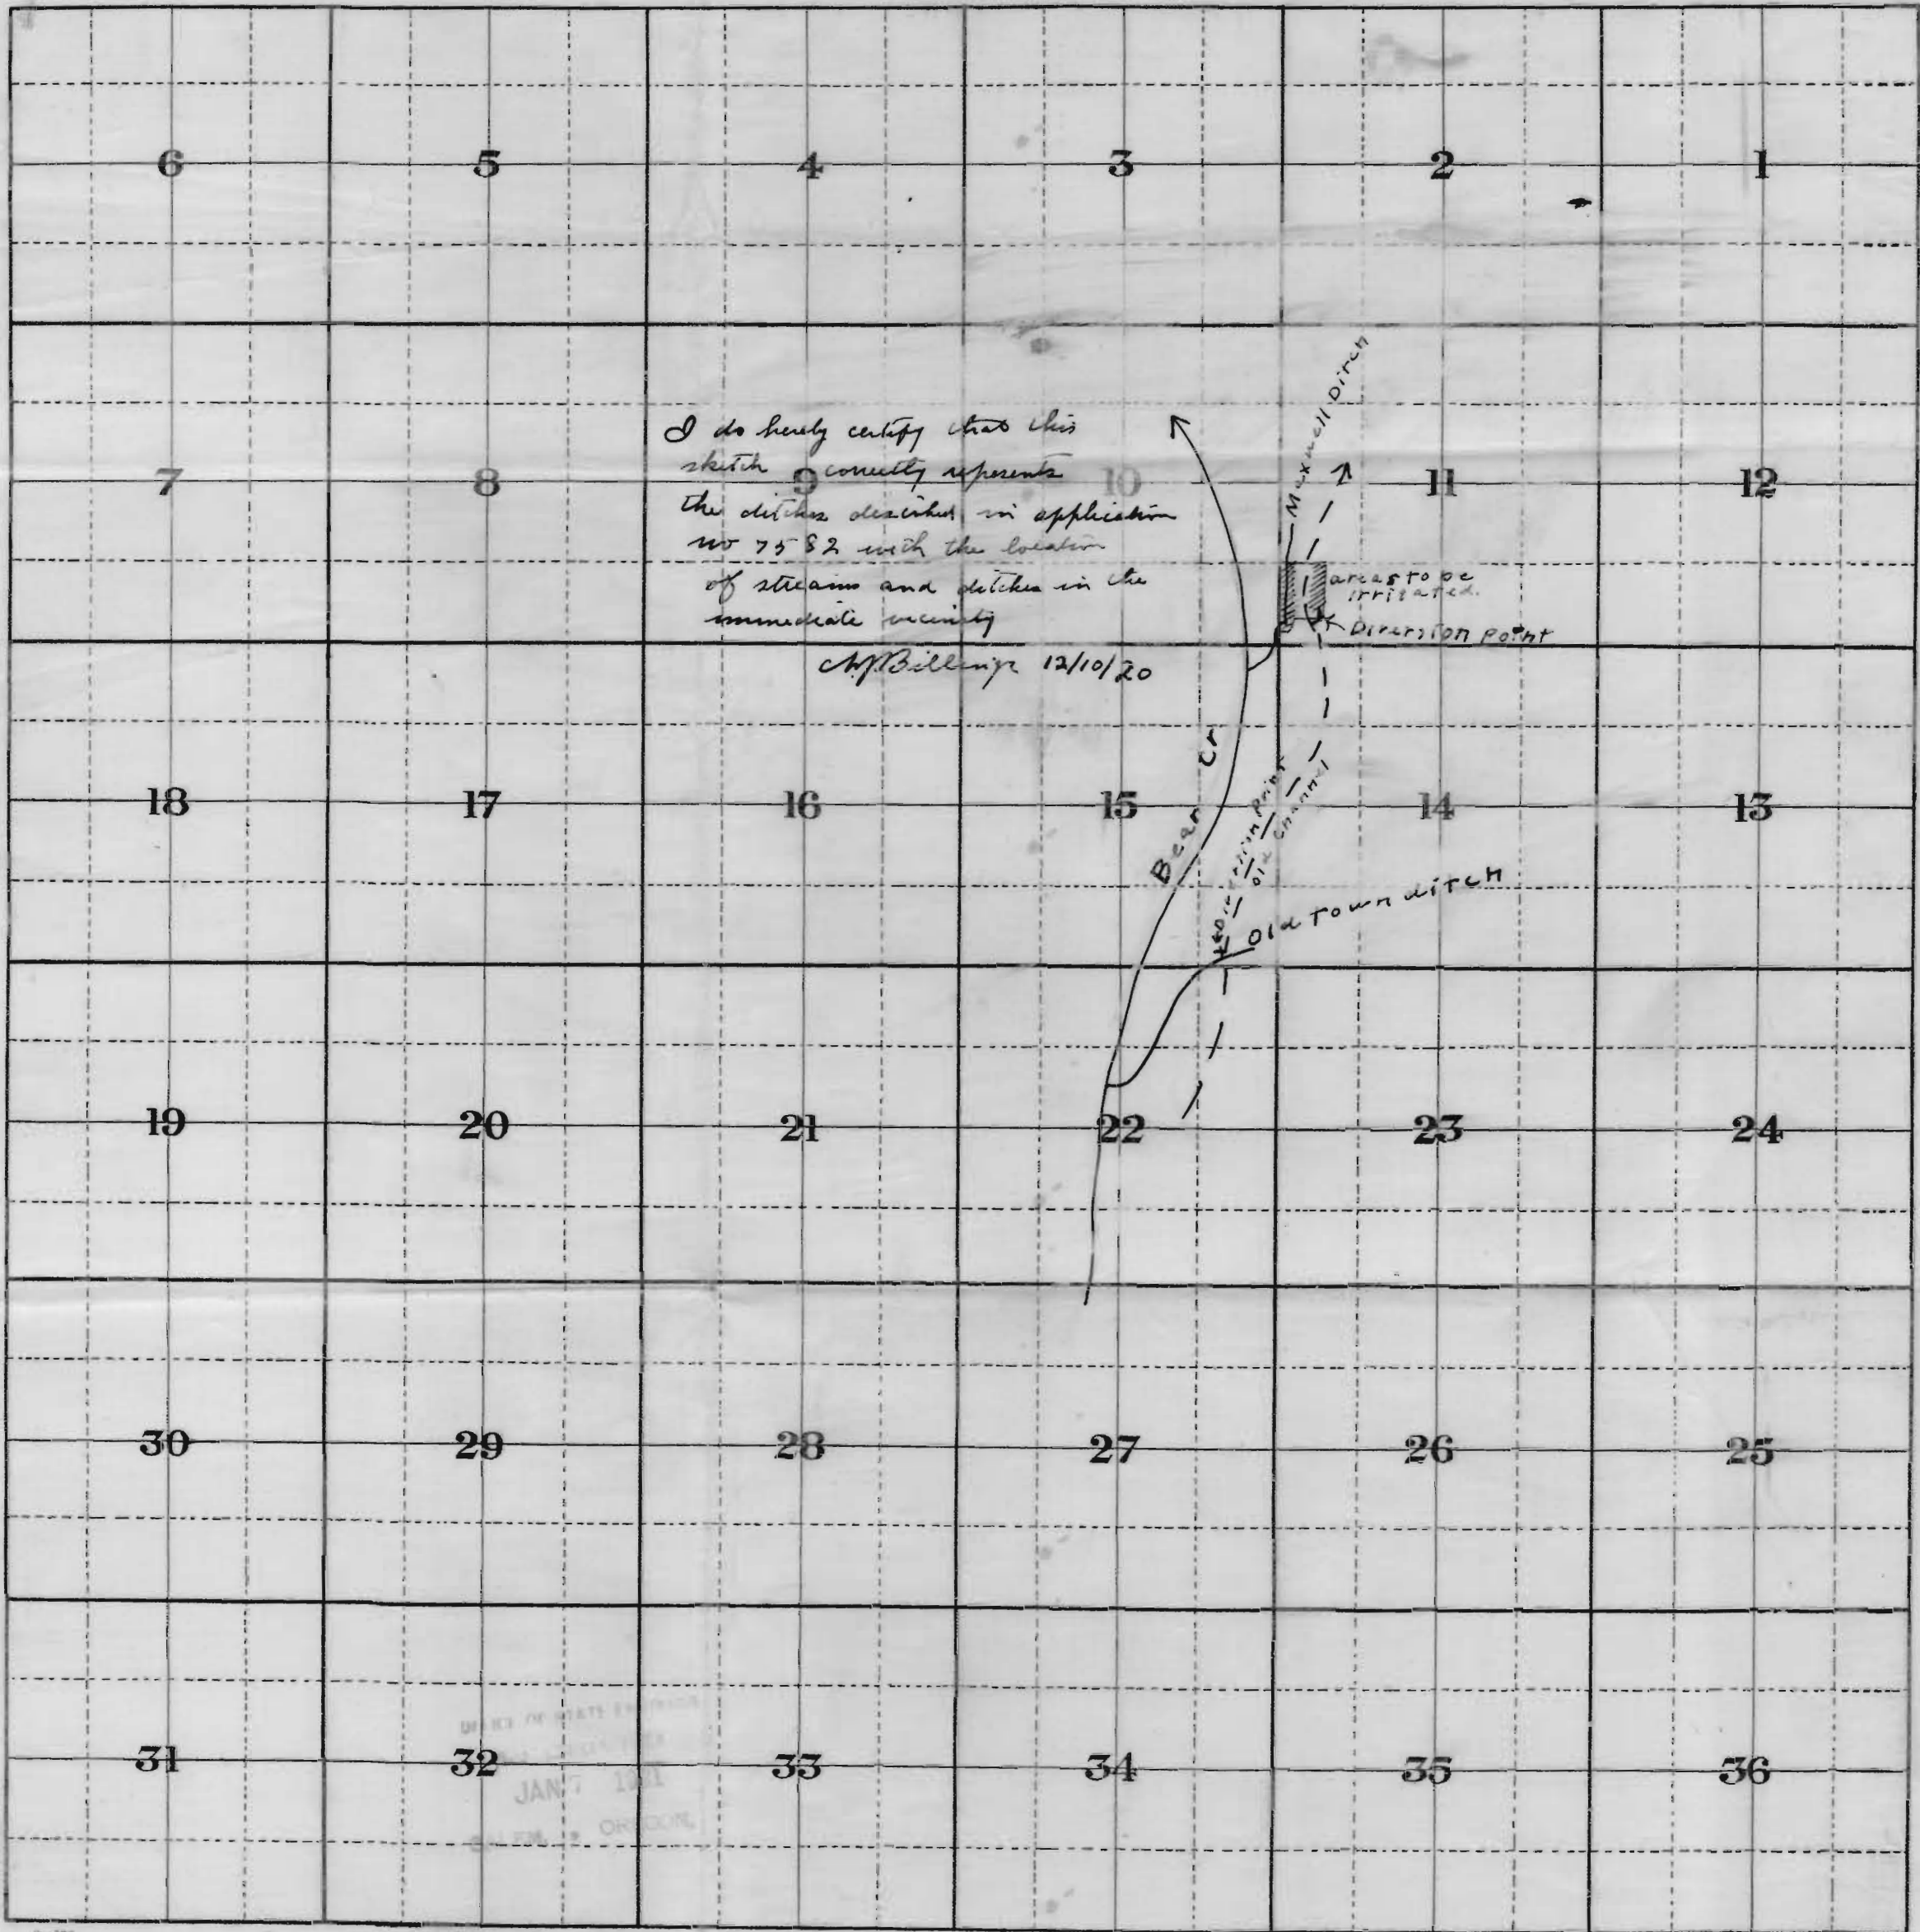

True meridian.

Application No. 7582
Permit No. 4897

SCALE.—Two inches = 1 mile.