


PLAT showing WATER RIGHT LOCATION

"E" on HUNSACKER CREEK

June - Scale 1"=1000' - 1909.

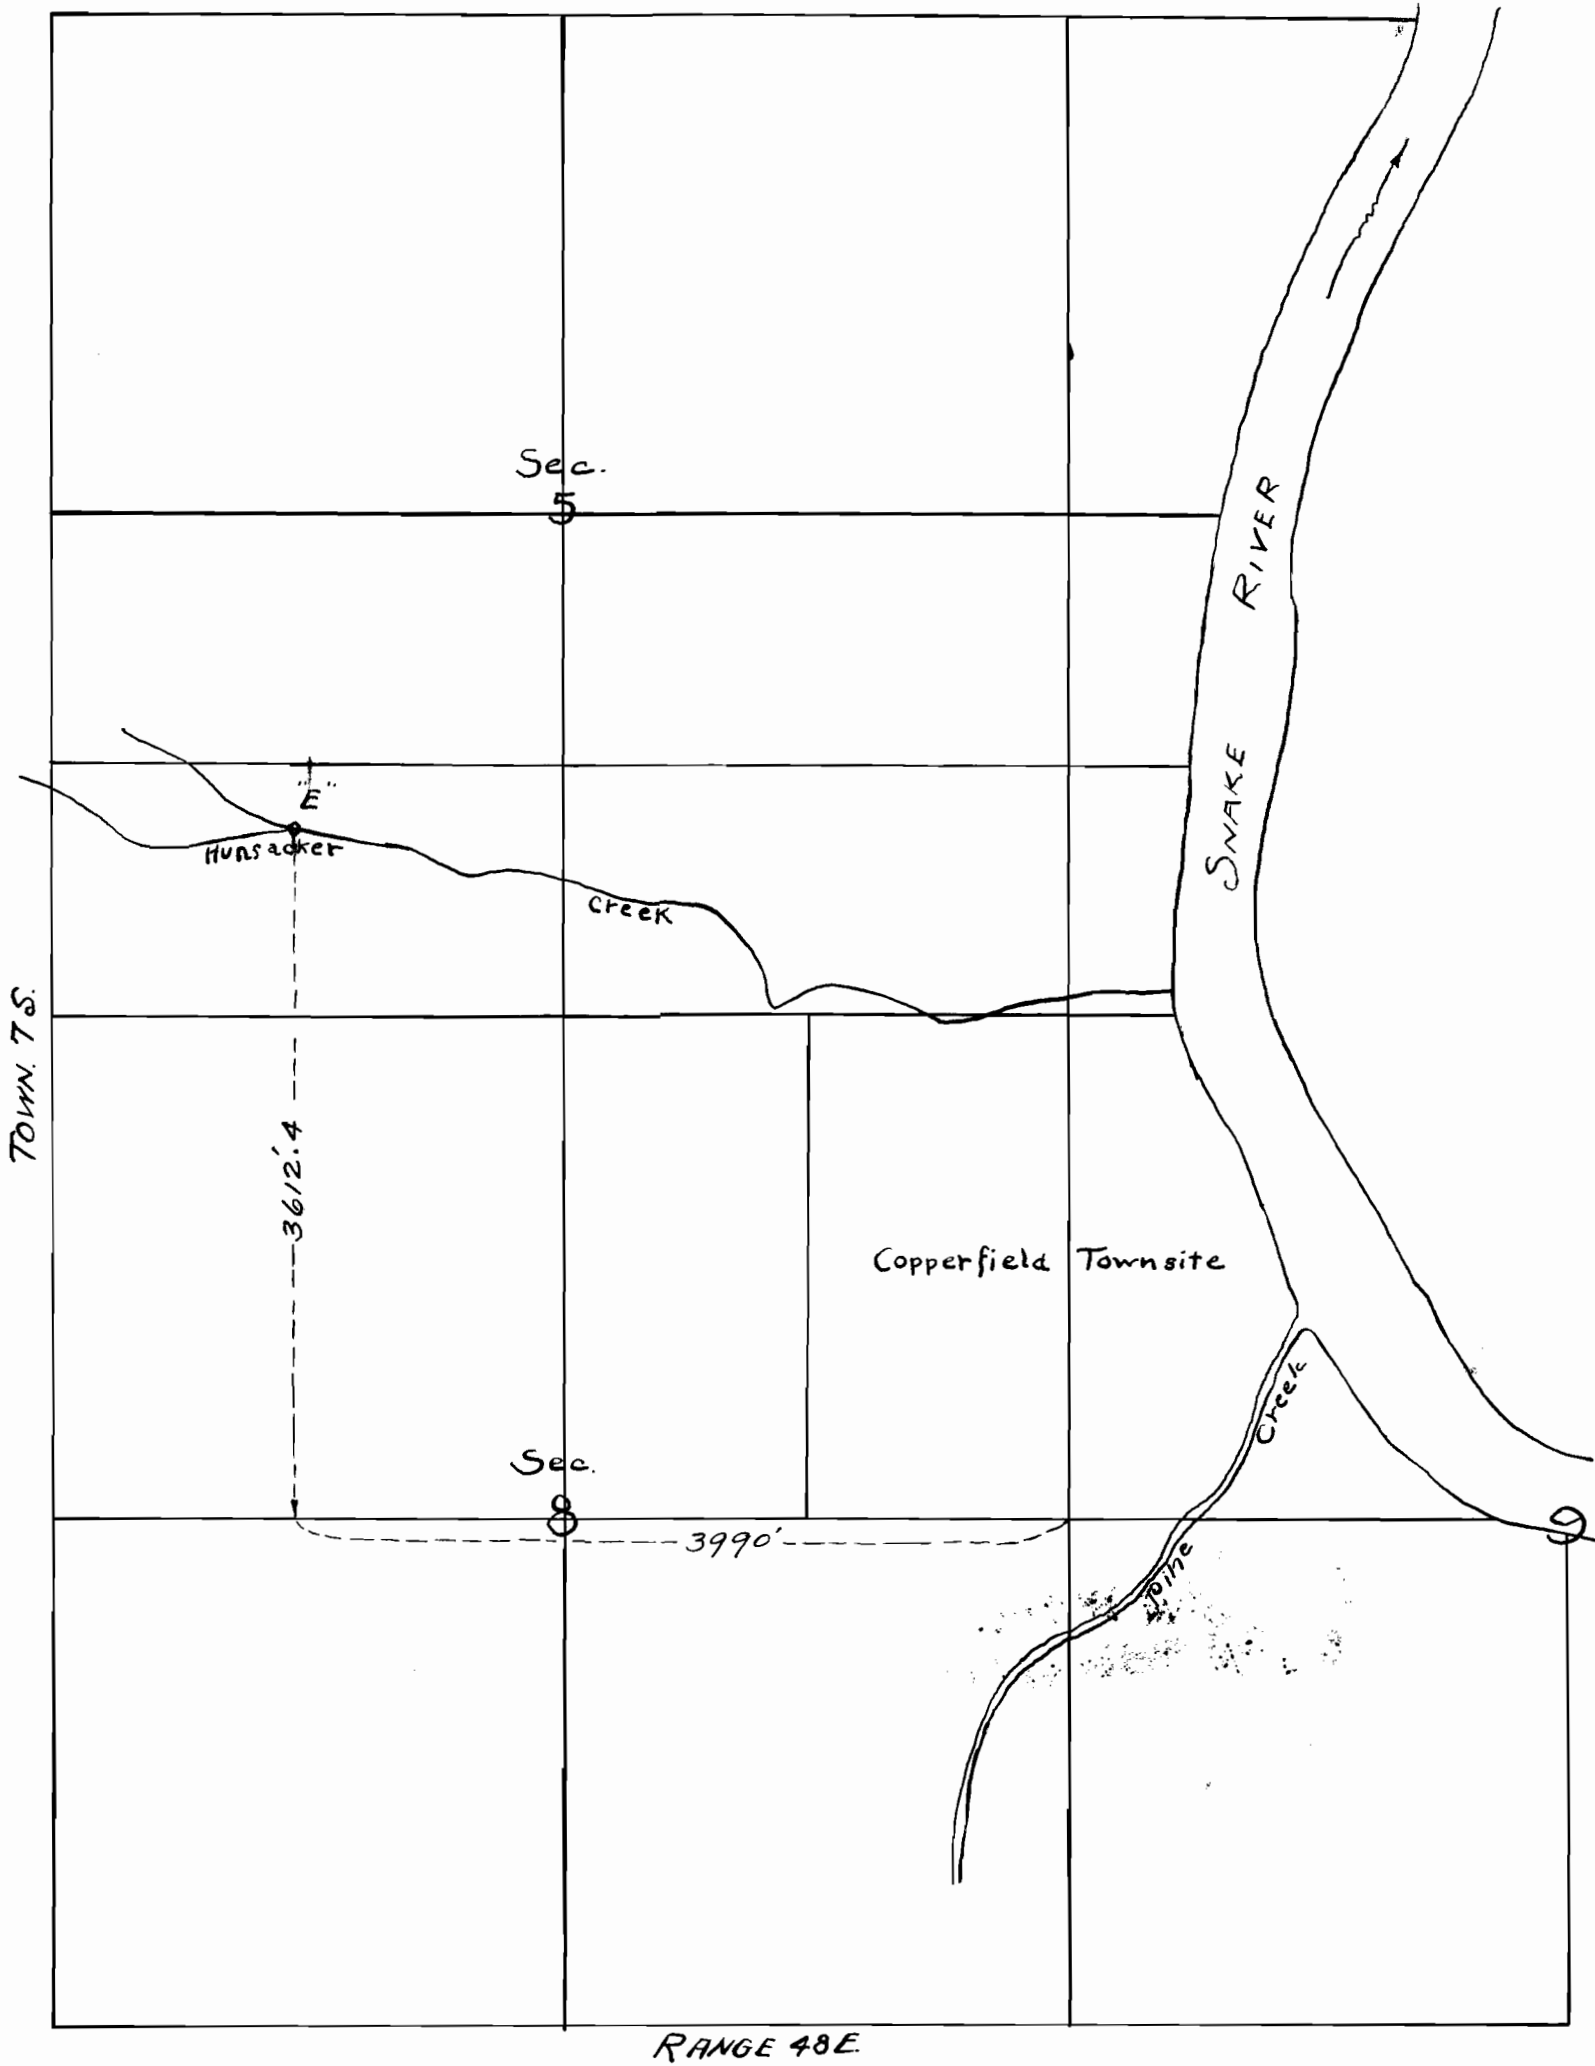

STATE OF OREGON,
County of Wheeler ss.

I, Henry J. Deuser, of Copperfield - Oregon hereby certify
that this map was made from notes taken during an actual survey made by me
on Tenth day of June 1909 and that it correctly
represents the works described in the accompanying application, together with the location of streams and
in the immediate vicinity.

H. J. Deuser
Surreyor
Subscribed and sworn to before me
This 11th day of July 1909
E. J. Morley
Justice of Peace

Application No. 173
Permit No. 49