


T. 26S. R. 4W. WM.

Scale: 1" = 150'

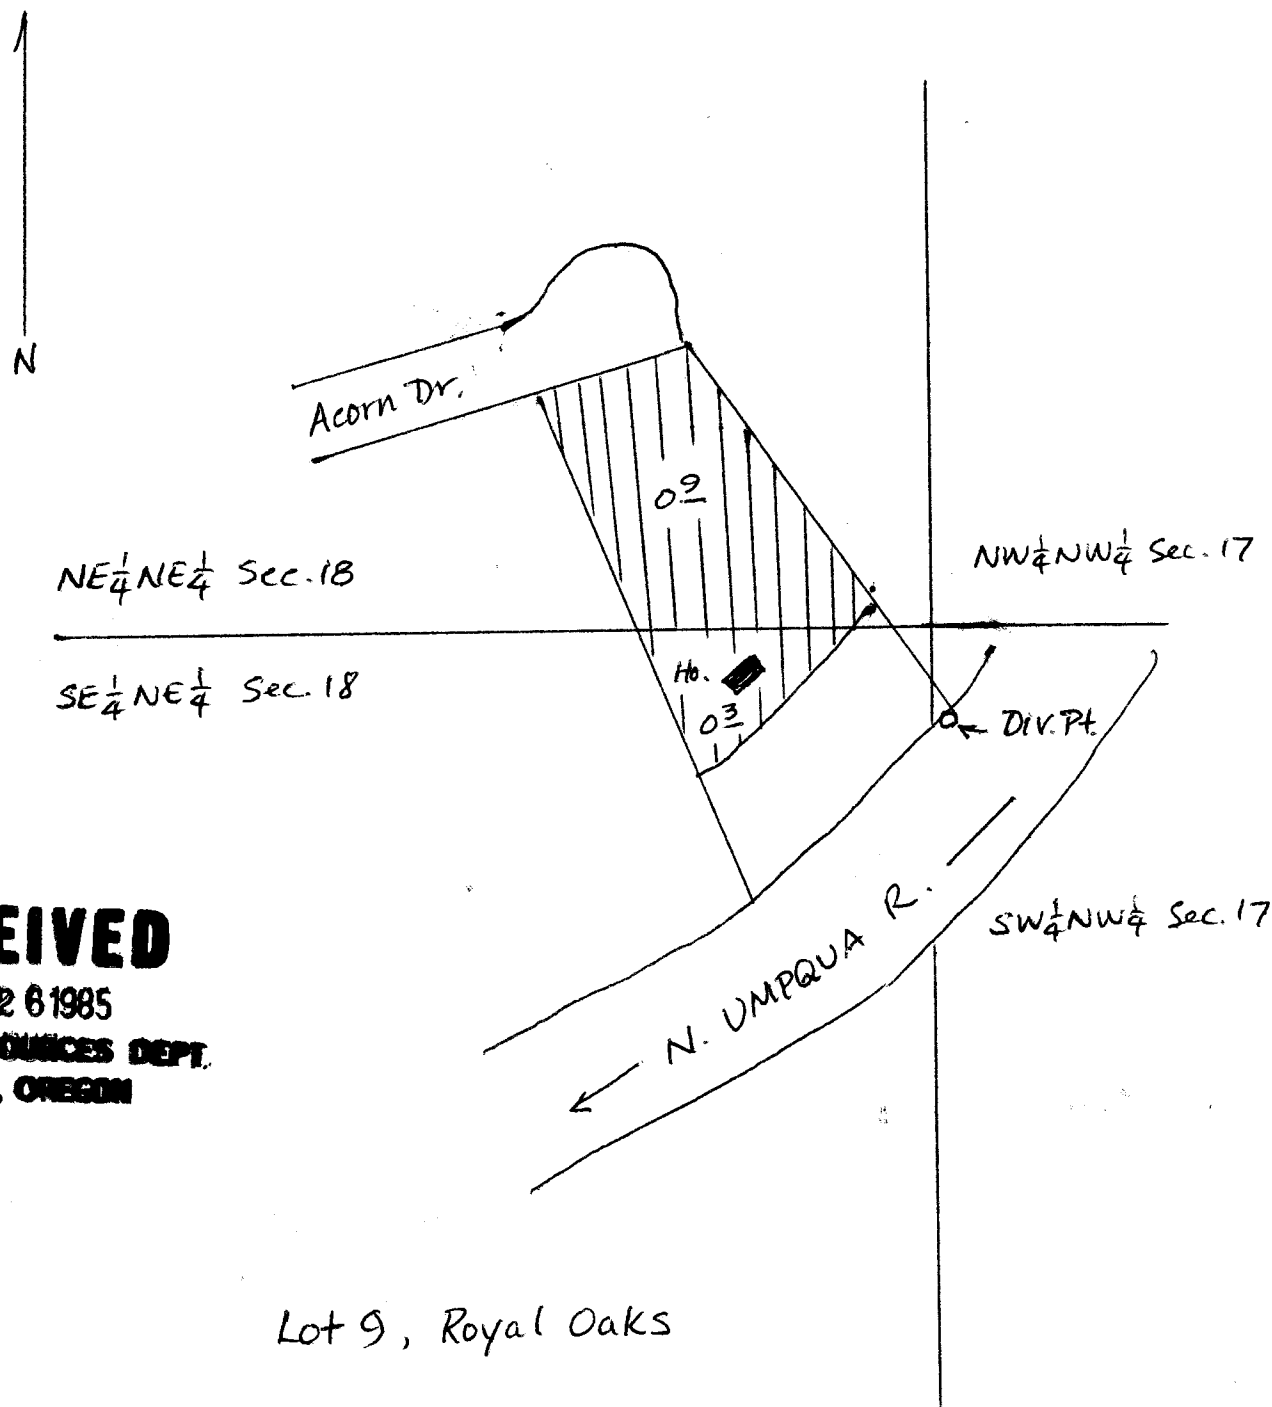

RECEIVED

FEB 26 1985

WATER RESOURCES DEPT.
SALEM, OREGON

Lot 9, Royal Oaks

DIV. PT: 75' S. and 15' E. from the
NW cor. of the SW 1/4 NW 1/4 Sec. 17.

Application No. 68285
Permit No. 49251