

RECEIVED

DEC 5 1984

WATER RESOURCES DEPT.
SALEM, OREGON

NW¹/₄ SEC 22 T.5N. R.36E.W.M.

6-6966
RECEIVED

AUG 24 1976


WATER RESOURCES DEPT.
SALEM, OREGON

16 | 15
21 | 22

RECEIVED

FEB 15 1985

WATER RESOURCES DEPT.
SALEM, OREGON

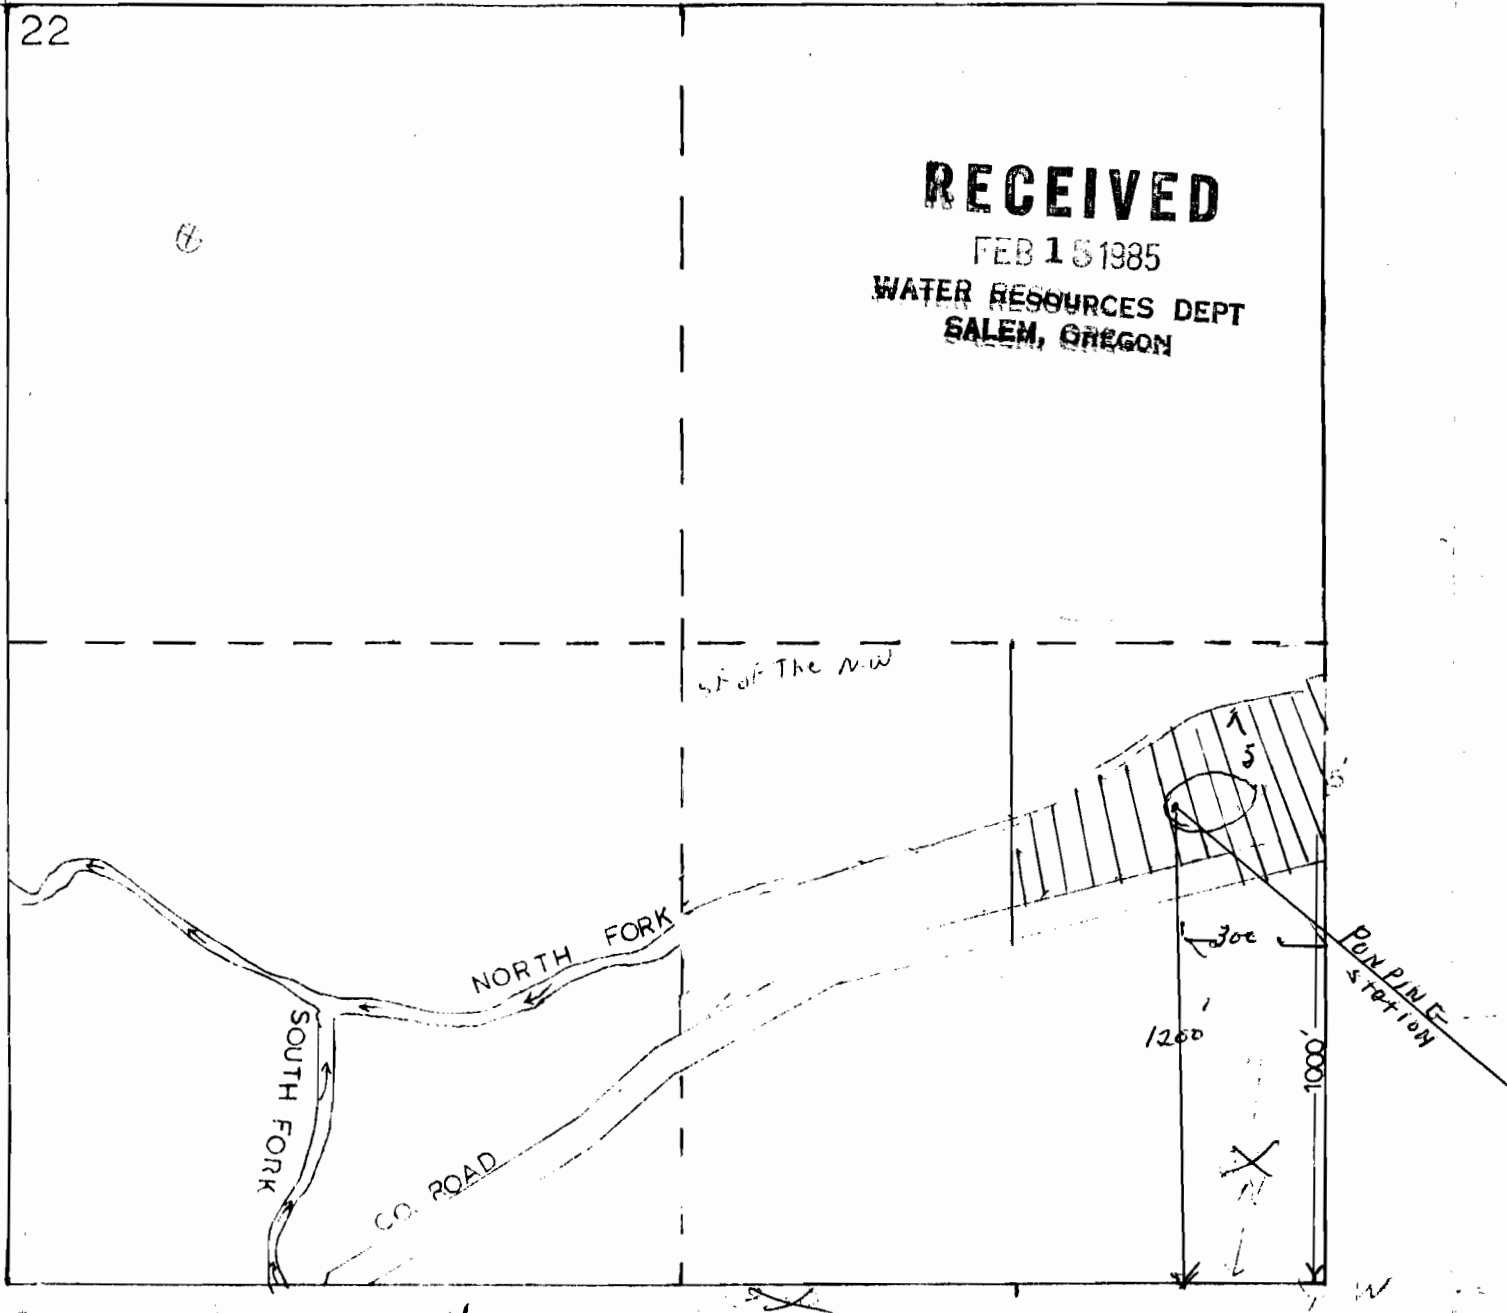

Application No. 68234
Permit No. 49268

SCALE = 1" = 400'

☐ LAND TO BE IRRIGATED

Application No. 68234
Permit No. 49268

