


39-8-16
49346

T. 39 S., R. 8 W., W. M.

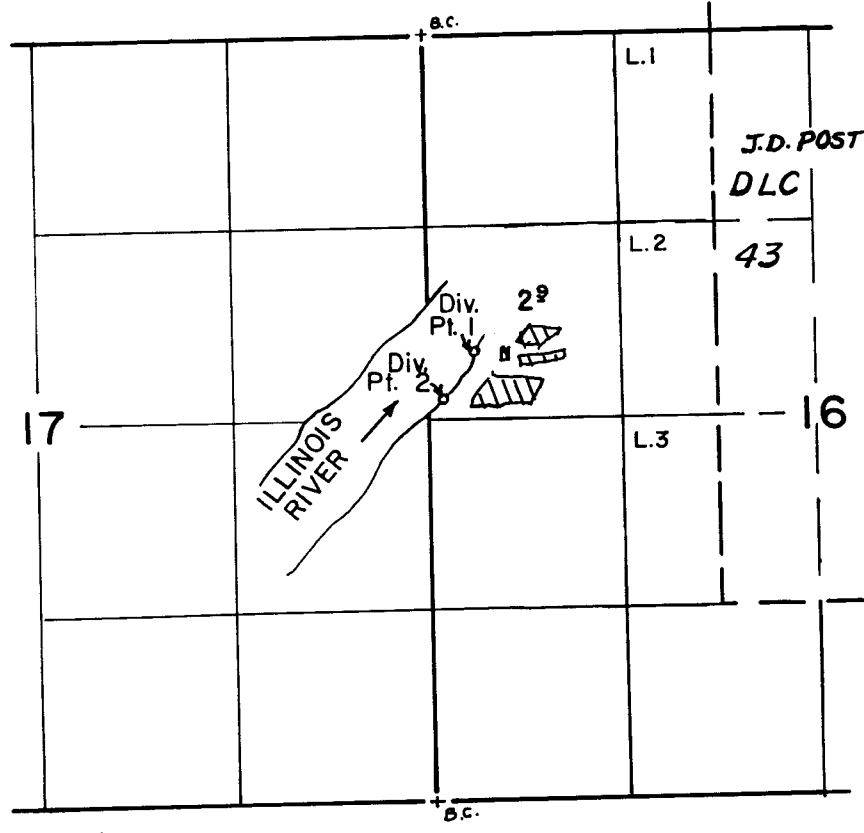

RECEIVED
OCT 29 1992
WM. DIST. 14
GRANTS PASS, ORE

Div. Pt. 1: 2170' S., 300' E.,
Div. Pt. 2: 2500' S., 100' E.,
both from NW cor. of Sec. 16

Scale: 1" = 1320'

FINAL PROOF SURVEY UNDER

Application No. 68129.. Permit No. 49346...
IN NAME OF

ROLLAND H. & MAE S. CARR

Surveyed MAY. 24. 1990., by R. S. JAMES...
& DEC. 10, 1991

11033-179-232 R
12/91
JMS