

T.13 S. R.26E. & 27E. W.M.


APPLICATION MAP FOR THE CITY OF DAYVILLE

Application No. 68264
Permit No. 49318

4" = 1 mile



-  CITY BOUNDRY
-  ADDITIONAL SERVICE AREA

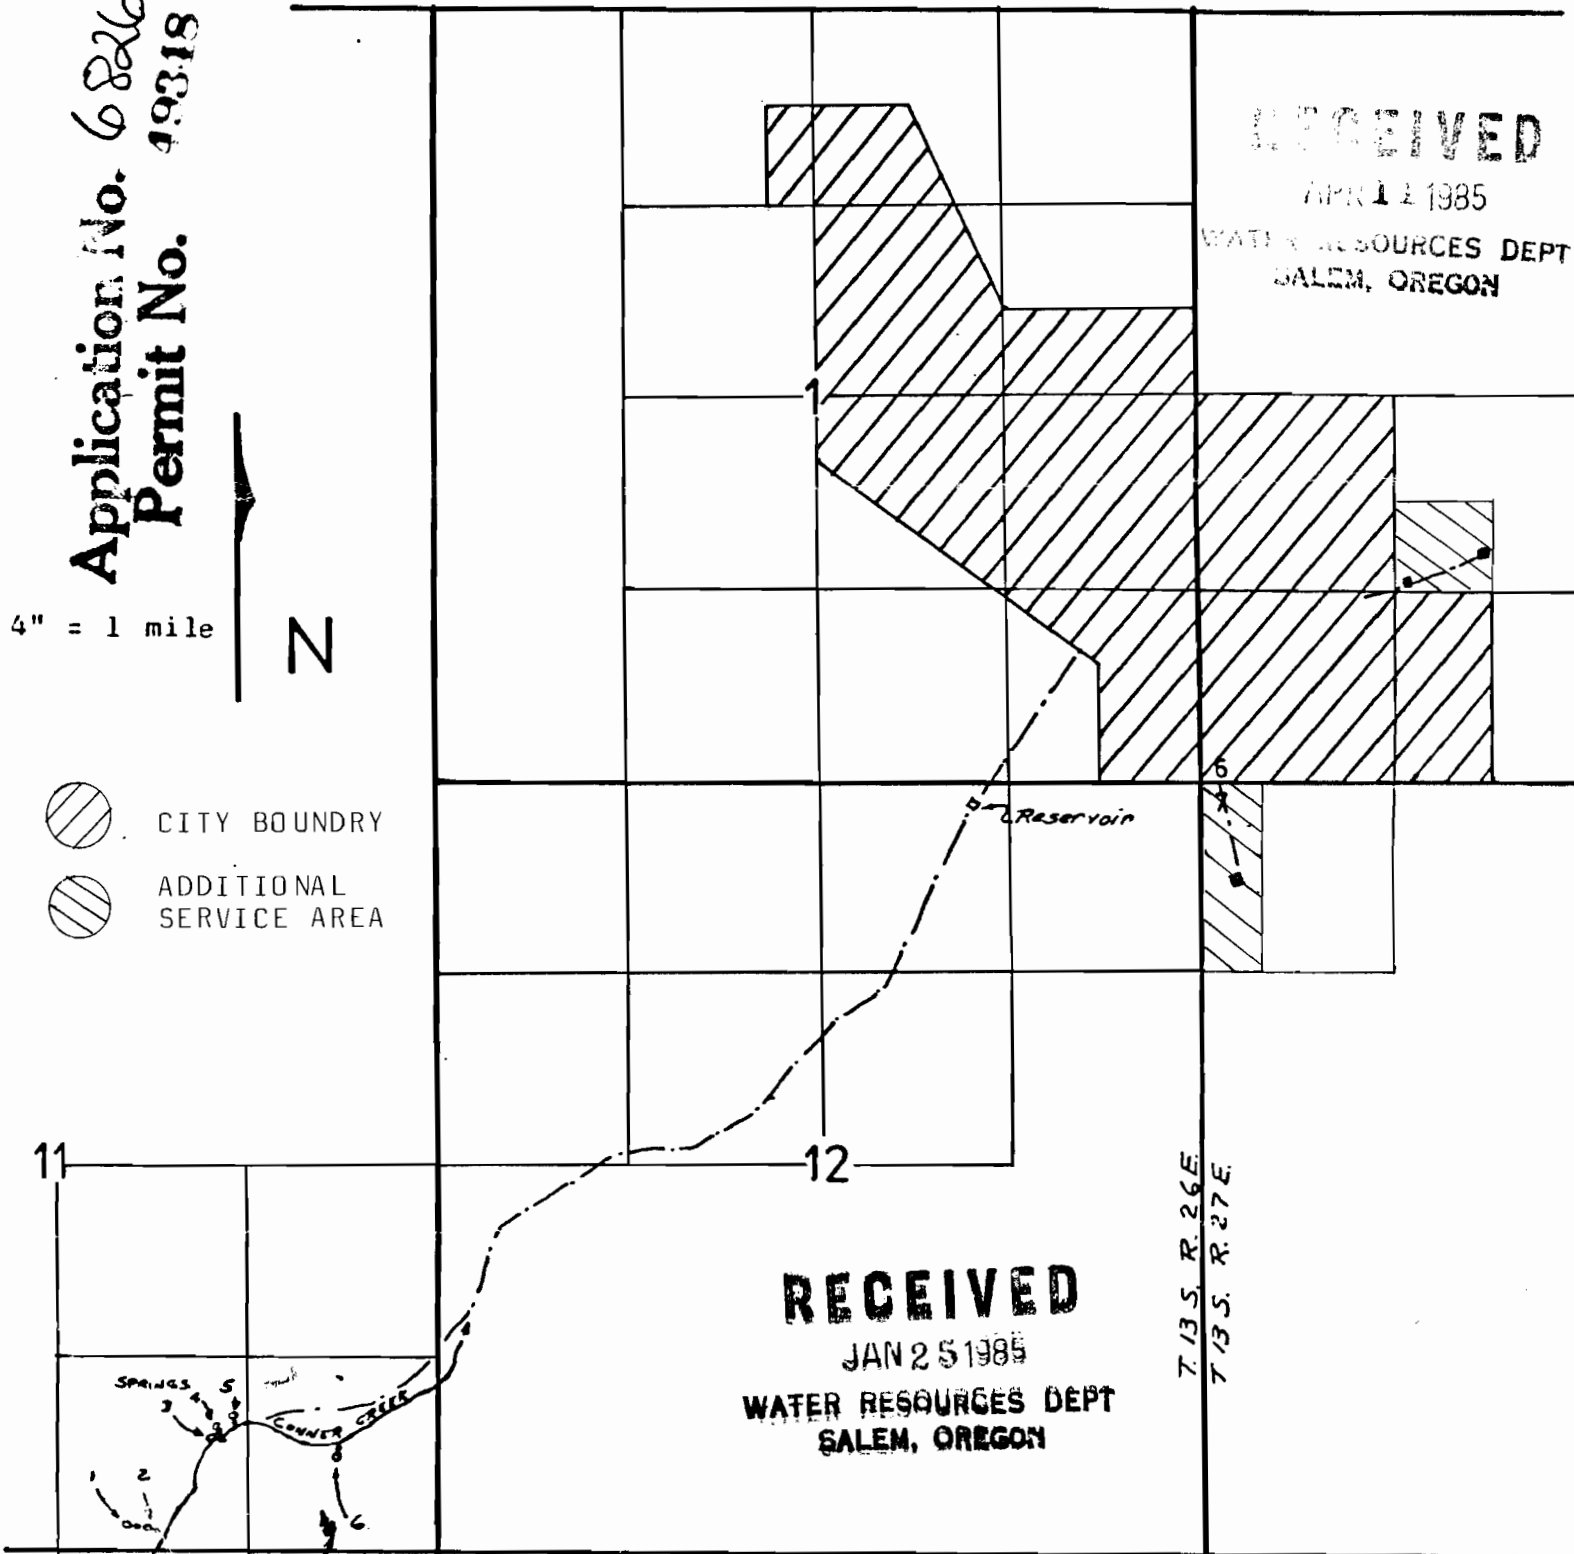

Spring Locations

- #1 - 2460'S & 2160'W
- #2 - 2480'S & 2000'W
- #3 - 1850'S & 1560'W
- #4 - 1780'S & 1520'W
- #5 - 1700'S & 1400'W
- #6 - 2000'S & 700'W
- #7 - ~~1400'S & 1200'W~~
2500 750

ALL from E 1/4 corner Sec. 11
T13S R26E WM

Corrected 2/20/85 28