

APPLICATION NO. 68294  
 PERMIT NO. 49352

OREGON DEPT. OF FISH & WILDLIFE

WATER RIGHTS MAP  
 SUMMER LAKE W.M.A.  
 T80S, R7E  
 LAKE COUNTY

1" = 1 MI.

**RECEIVED**


MAR 11 1985

WATER RESOURCES DEPT  
 SALEM, OREGON



INDICATES AREA WHERE  
 WATER TO BE USED

# T. 30 S., R. 17 E., W.M.

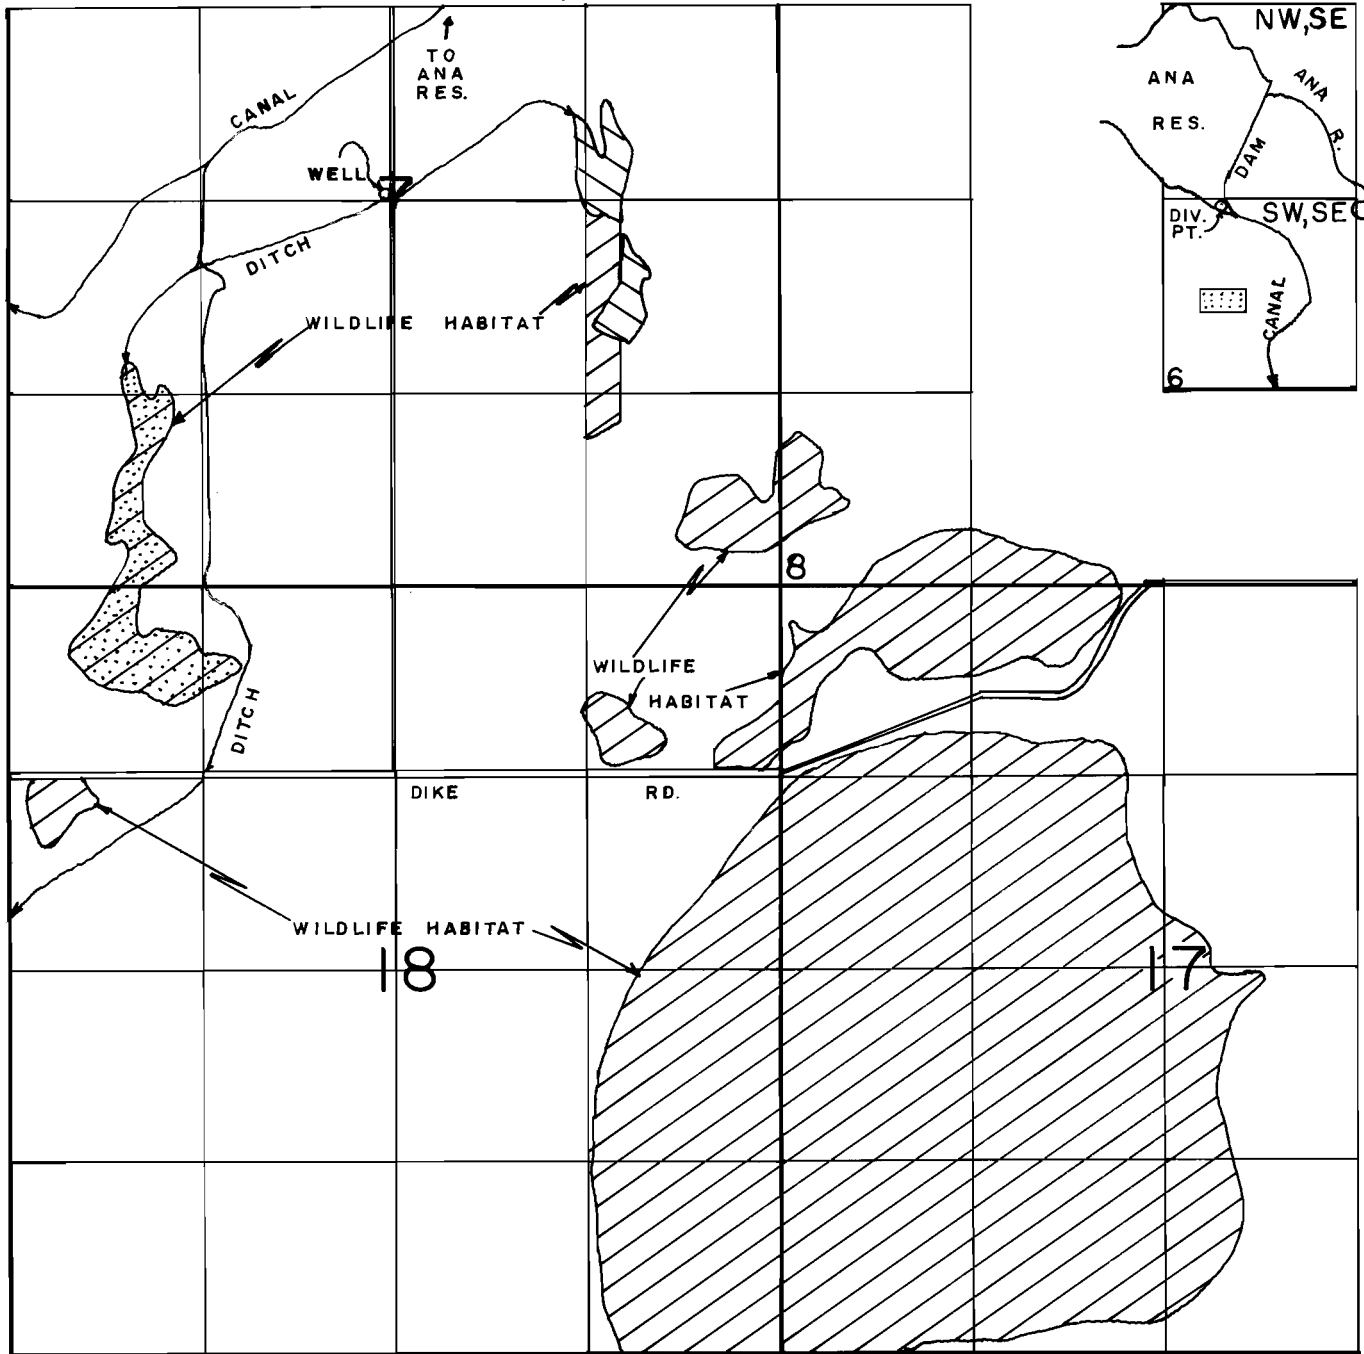

## FINAL PROOF SURVEY

UNDER  
 G-11558      G-10687  
 G-10414      G-10433  
 Application No. 68294      Permit No. 49352  
 IN NAME OF

### OREGON DEPARTMENT OF FISH AND WILDLIFE

Surveyed OCT 19, 1993, by R.M.SUTTERFIELD

WELL LOC: 30' N & 50' W FROM CEN COR. OF SEC 7.    
 DIV. PT. LOC: 1260' N & 2240' W FROM SE COR. OF SEC 6. 