

UNITED STATES DEPARTMENT OF AGRICULTURE
FOREST SERVICE

MAP SHEET

No.

Siuslaw

National Forest.

Division

District

Portland

Block

T. *4 S.*R. *10 W.*

W.

M., Section

13

Quarter

NW

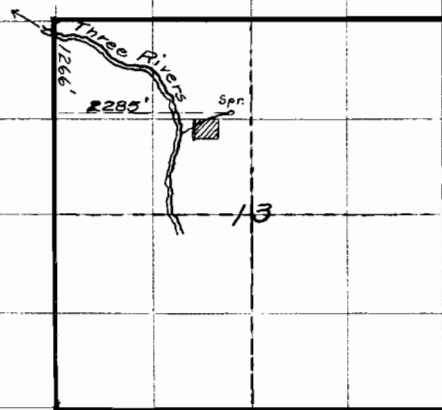
Mapped by

R.S. Shelley, Forest Supervisor.

Scale:

2

inches = 1 mile.

*7732*
4940