


TWP. 36 S. R. 5 W.

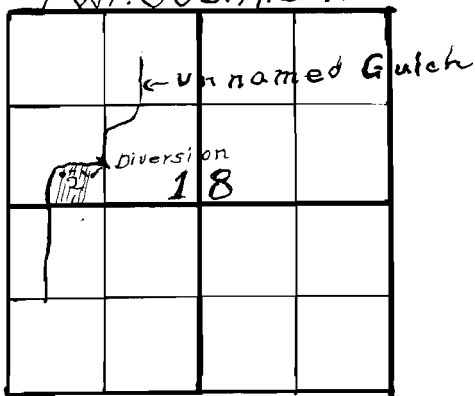

7736
4942