


Permit: S 49431
Volume: 5
Strm: UNN STR
Trib: JUMPOFF JOE CR
Priority: 6/04/85

T. 35S., R. 7 W., W. M.

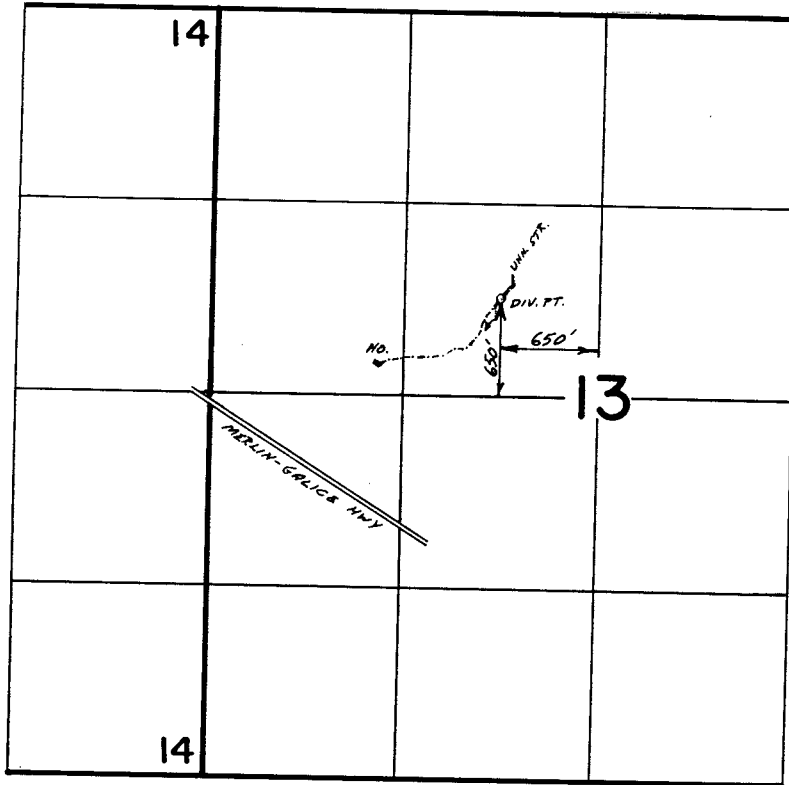

Scale : 1" = 1320'



FINAL PROOF SURVEY UNDER

Application No. **68367** Permit No. **49431**
IN NAME OF

HAROLD PAUL BAIMA

Surveyed **Oct. 28, 1987**, by **B.S. JAMES**