

Permit: S 49486
Volume: 6
Strm: APPLGATE LAKE RES
Trib: APPLGATE R
Priority: 6/10/85

Application No. 68381
Permit No. 49486


WATER RESOURCES DEPT
SALEM, OREGON

T 37 S R 6 W W.M.

AUG 30 1985

SCALE 4" = 1 MILE

WATER RESOURCES DEPT
SALEM, OREGON

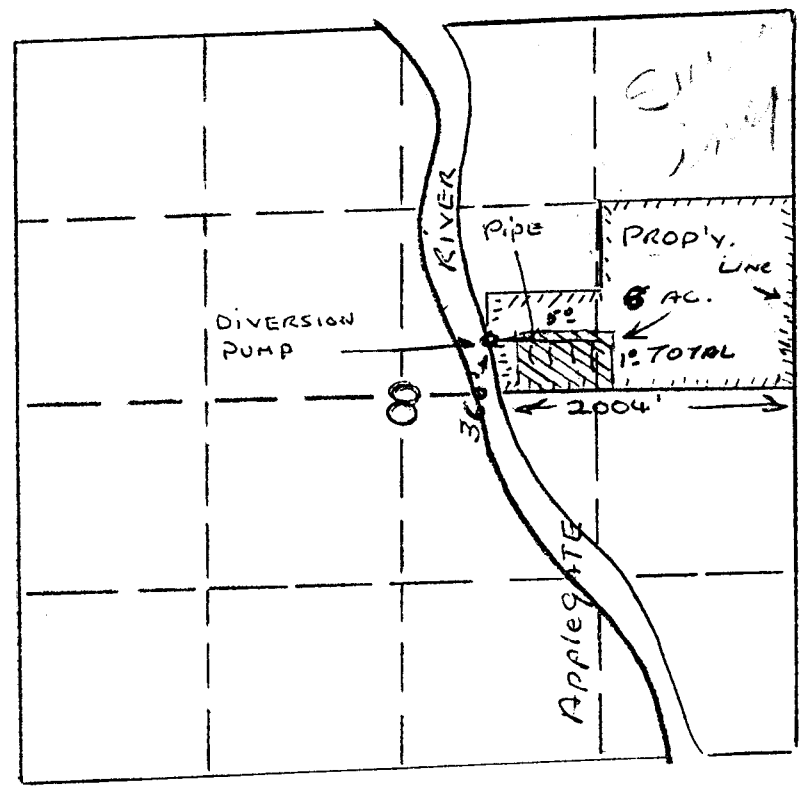

5 acres in 37 S 6W 8 SW 1/4 NE 1/4
1 acre in 37 S 6W 8 SE 1/4 NE 1/4