




T. 34 S., R. 6 W., WM.

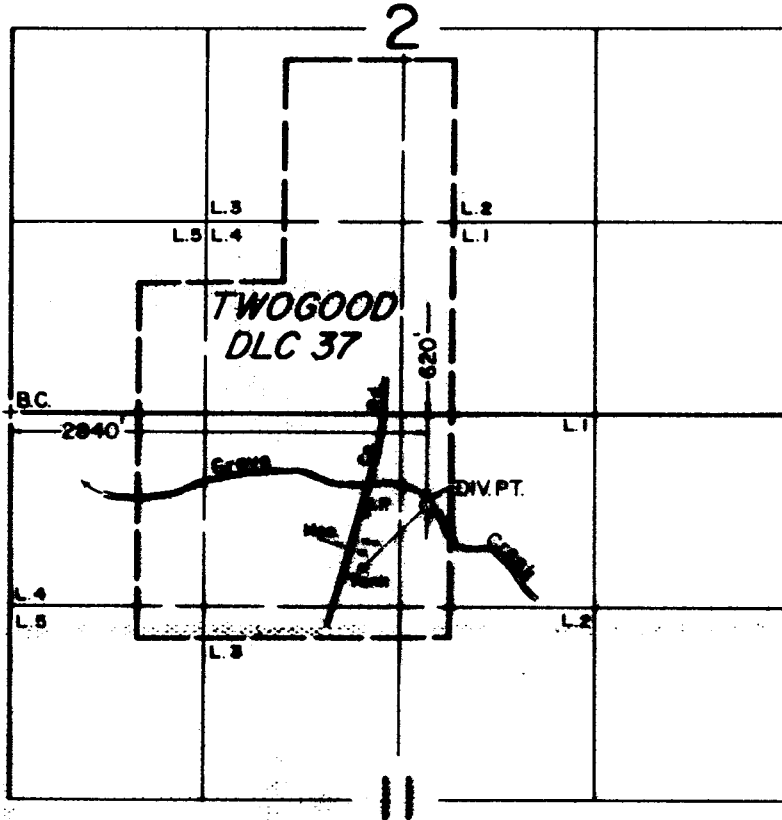

SCALE: 1" = 1320'

FINAL PROOF SURVEY
UNDER

Application No. ~~68554~~ Permit No. ~~49501~~.....
IN NAME OF

.....**JOSEPH J. ORRIO**.....

Surveyed MAY 3..... 1989., by B. S. JAMES.....

*road
1/4-70*

7-20-89
41033-179-131L *JS*