


T. 35 S., R. 7 W., W. M.

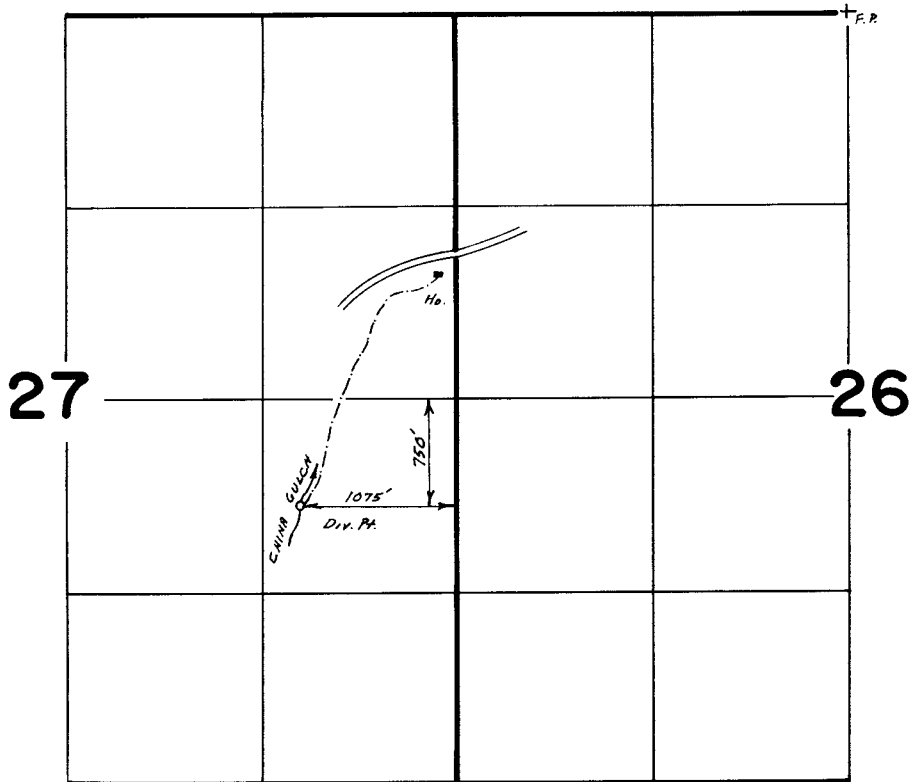

Scale 1"=400'

FINAL PROOF SURVEY
UNDER

Application No. 68601... Permit No. 49560.....
IN NAME OF

MARY G. THOMAS.....

Surveyed Oct. 29, 1987, by B.S. JAMES.....

RECEIVED

JUL 25 1891

WM. DIST. 14
GRANTS PASS, ORE.

41033-179-165 R

By