


T. 6 S., R. 1 E. W.M.

RECEIVED

JAN 15 1986

WATER RESOURCES DEPT.
SALEM, OREGON

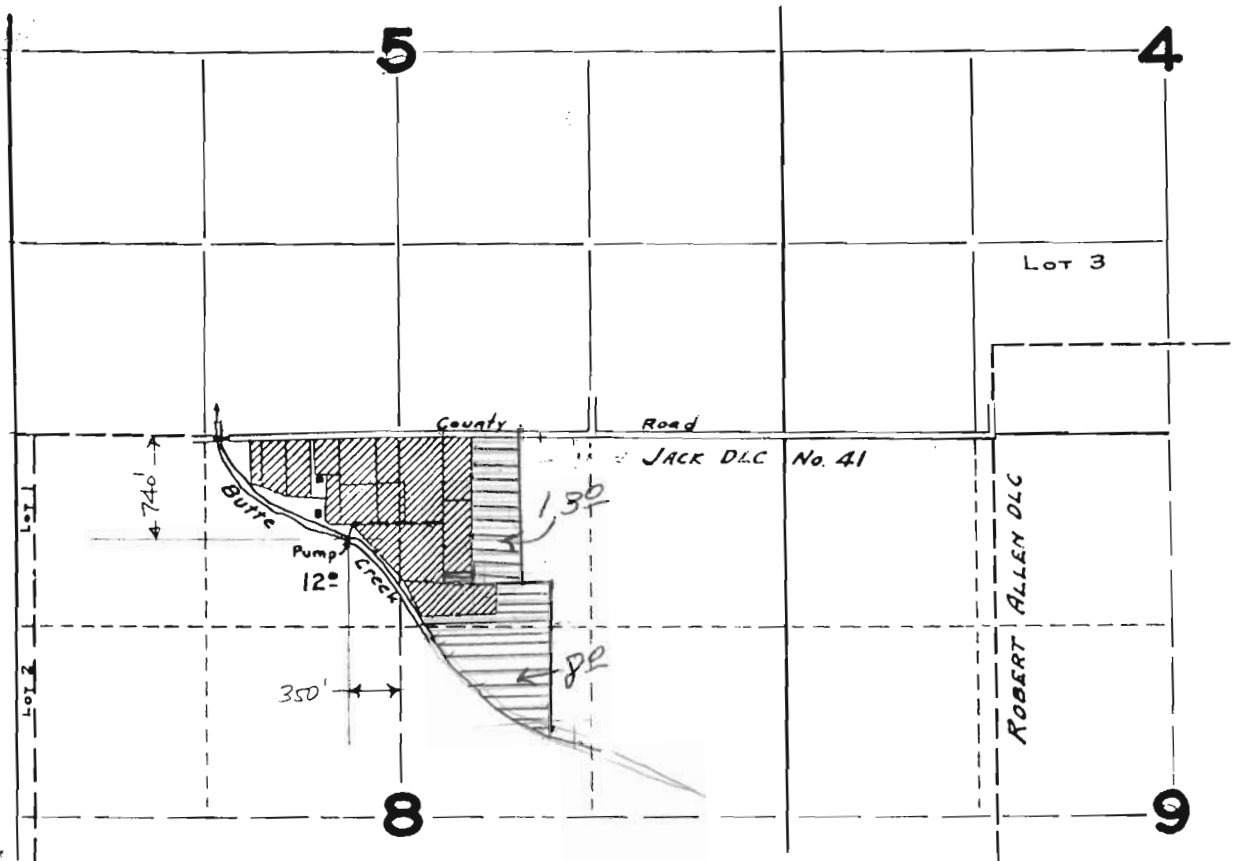

NEW LANDS TO BE IRRIGATED.



LANDS COVERED UNDER CERTIFICATE 14391

Application No. 68649
Permit No. 49627