


RECEIVED

JAN 21 1986
WATER RESOURCES DEPT.
SALEM, OREGON

Application No. 68653
Permit No. 49628

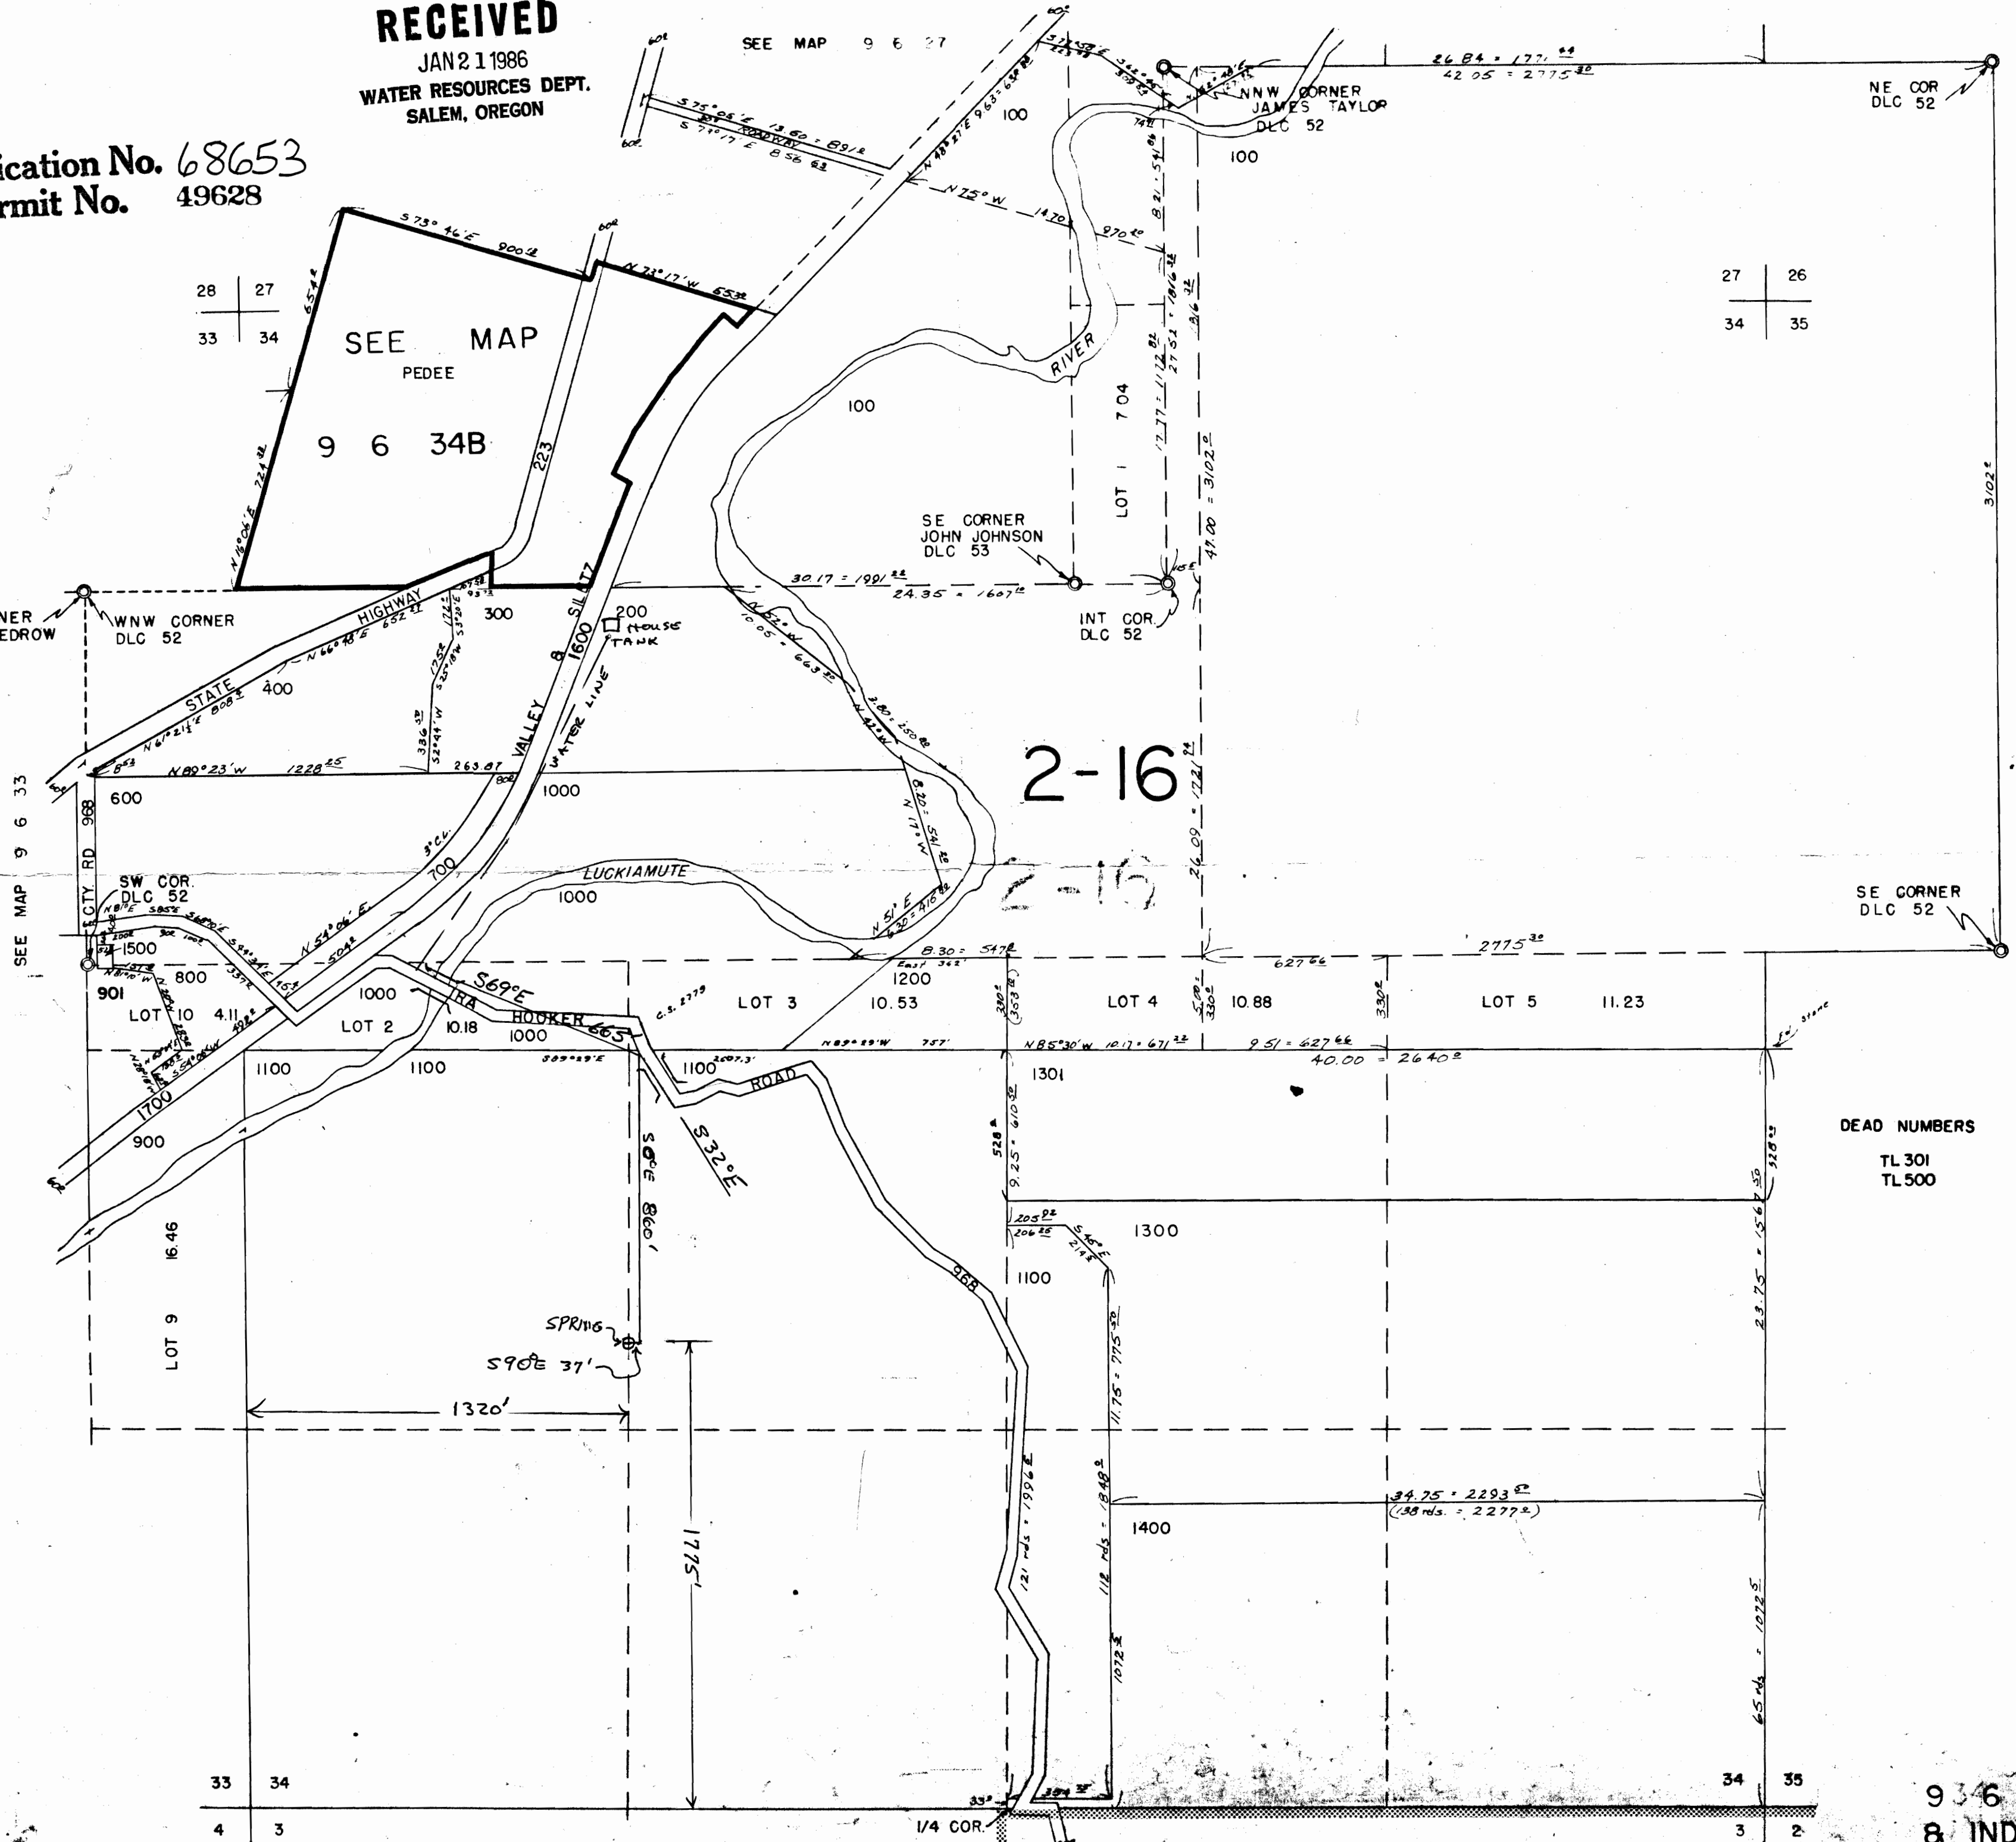

2-16

2-16

DEAD NUMBERS
TL 301
TL 500