

Evergreen Parkway

NE 1/4 NW 1/4 SEC 28

NW 1/4 NE 1/4 SEC 28

NE 1/4 NE 1/4 SEC 28

28 27

21 22

SE 1/4 NW 1/4 28

SW 1/4 NE 1/4 SEC 28

SE 1/4 NE 1/4 SEC 28 156.6'

SW 1/4 NW 1/4 SEC 27

245th Ct

Dawson Creek Dr.


N-S Baseline


BOUNDARY 2

791.4'

229.6'


245.6'

#2

#3

#10

Dawson Creek Dr.

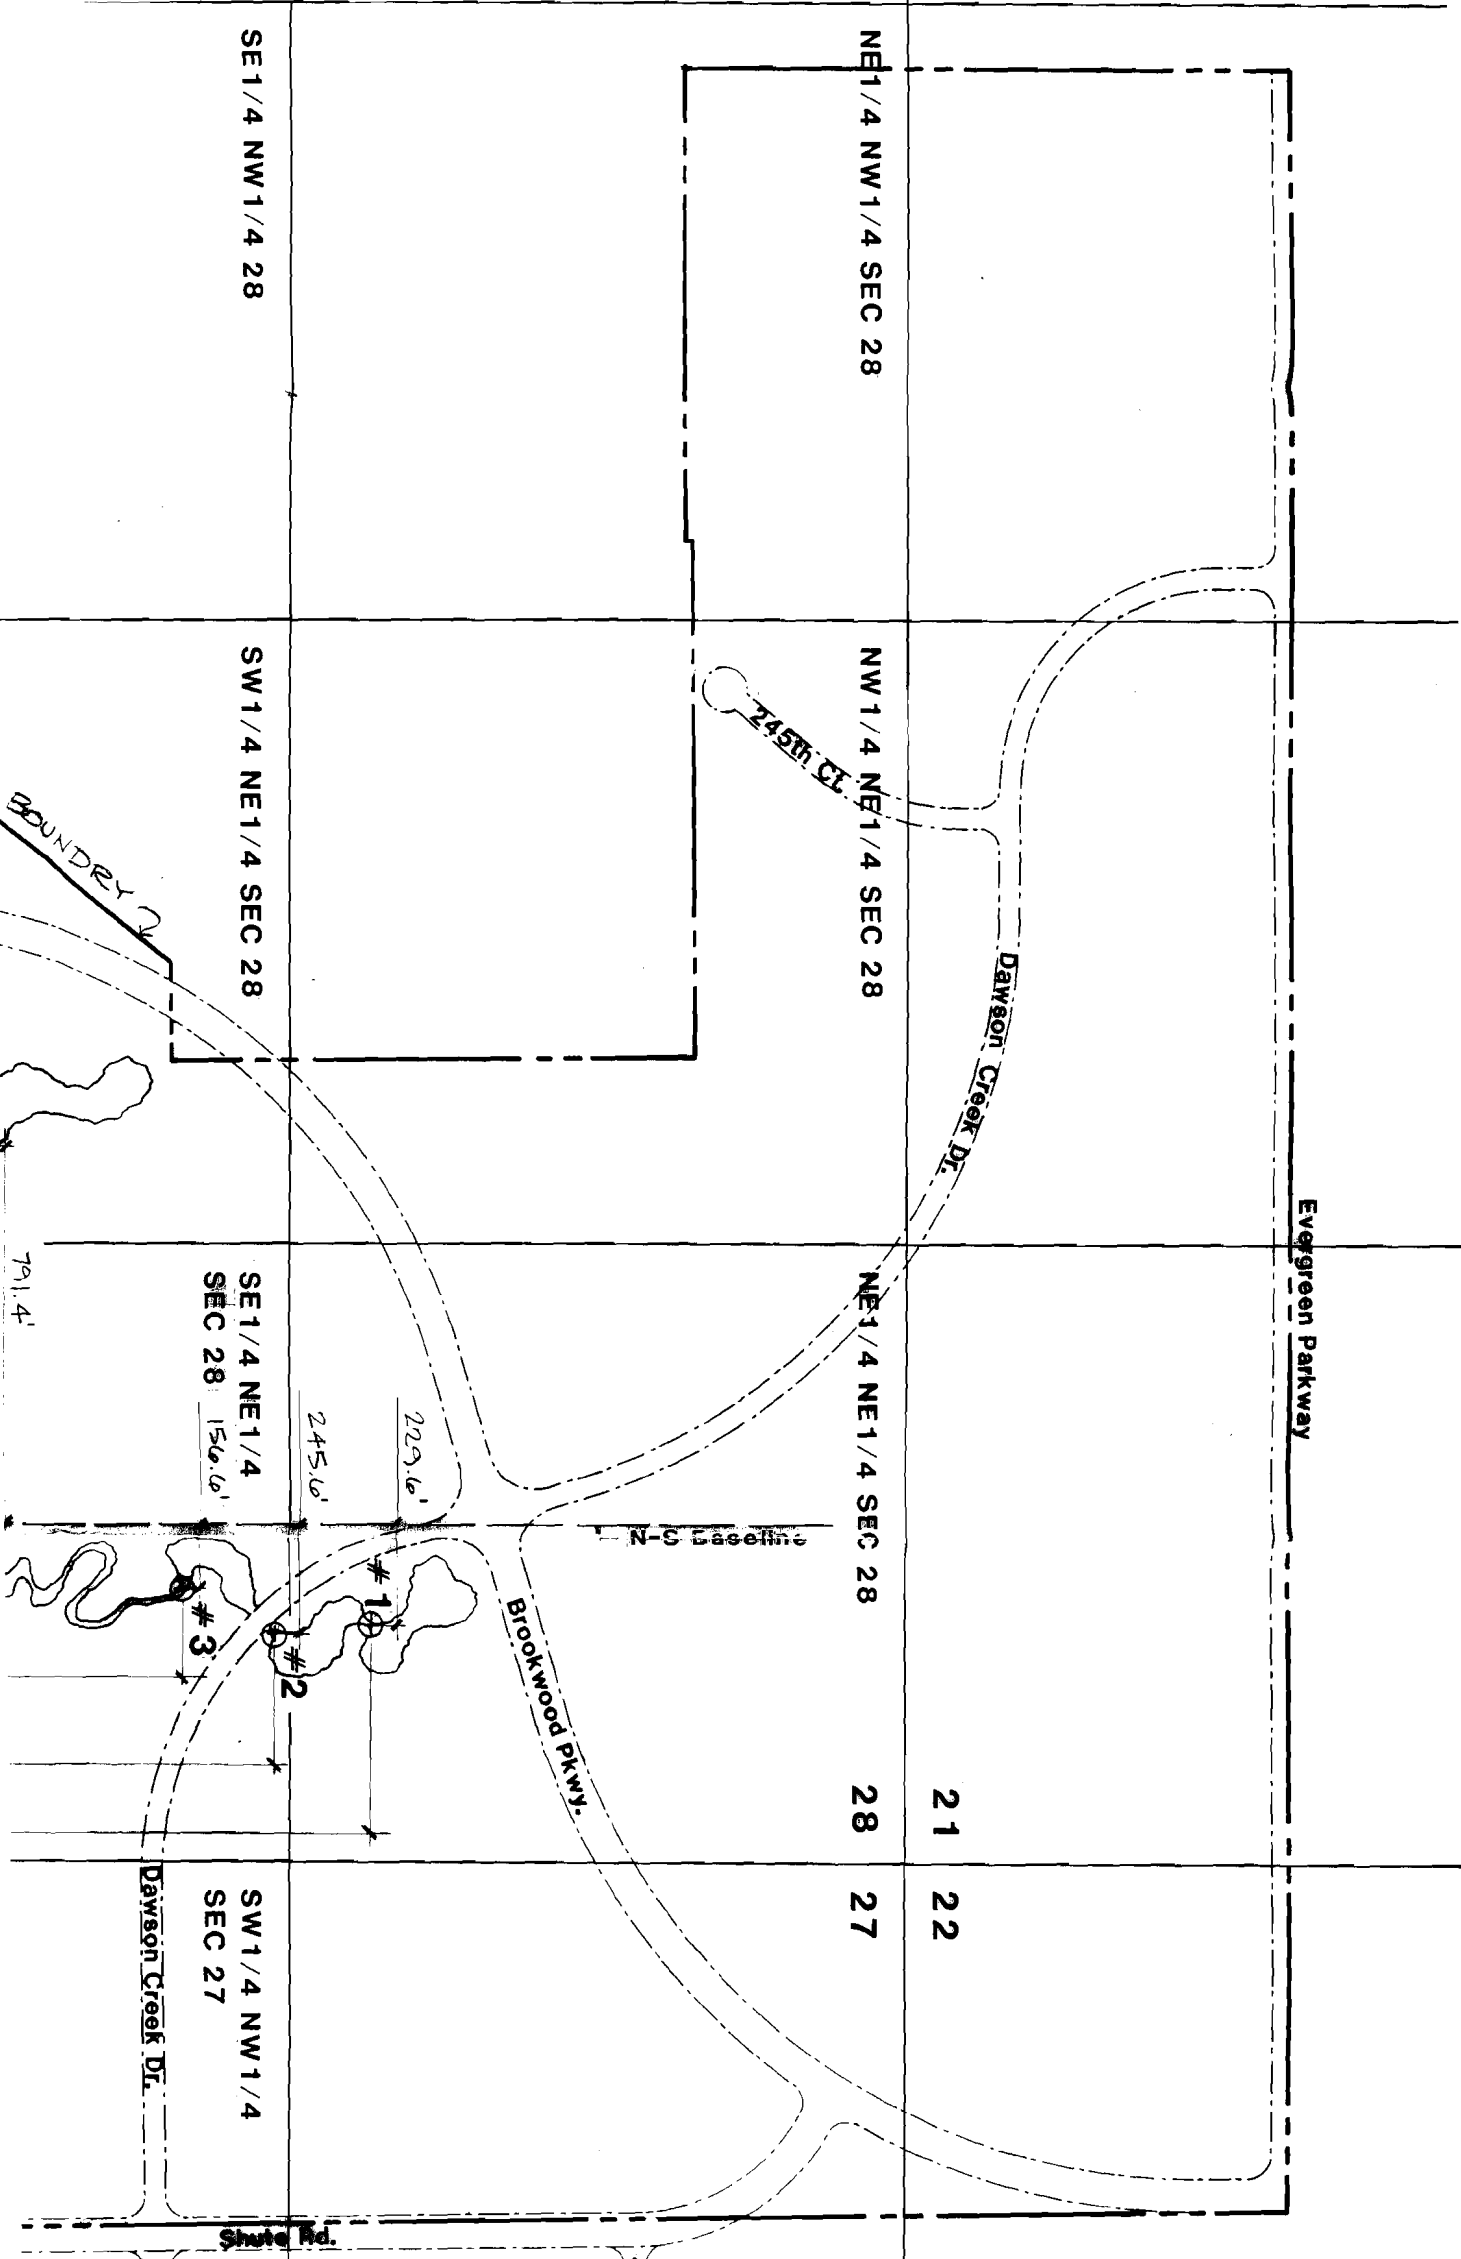

28

SEC 28

SW 1/4 NE 1/4 SEC 28

NW 1/4 SE 1/4 SEC 28

SE 1/4 NE 1/4 SEC 28

NE 1/4 SE 1/4 SEC 28

SW 1/4 NW 1/4 SEC 27

NW 1/4 SW 1/4 SEC 27

PROPERTY BOUNDARY 2

Brookwood Pkwy.

Dawson Creek Dr.

Shute Rd.

Amber Rd.

E-W Baseline

1833.3'

1201.3'

1218.3'

1750.3'

2293.3'

2488.3'

2696.3'

791.4'

502.9'

514'

245.6'

229.6'

#7

#5

#6

#4

#3

#2

#10

NW Corner DLC # 45
N 990.717

