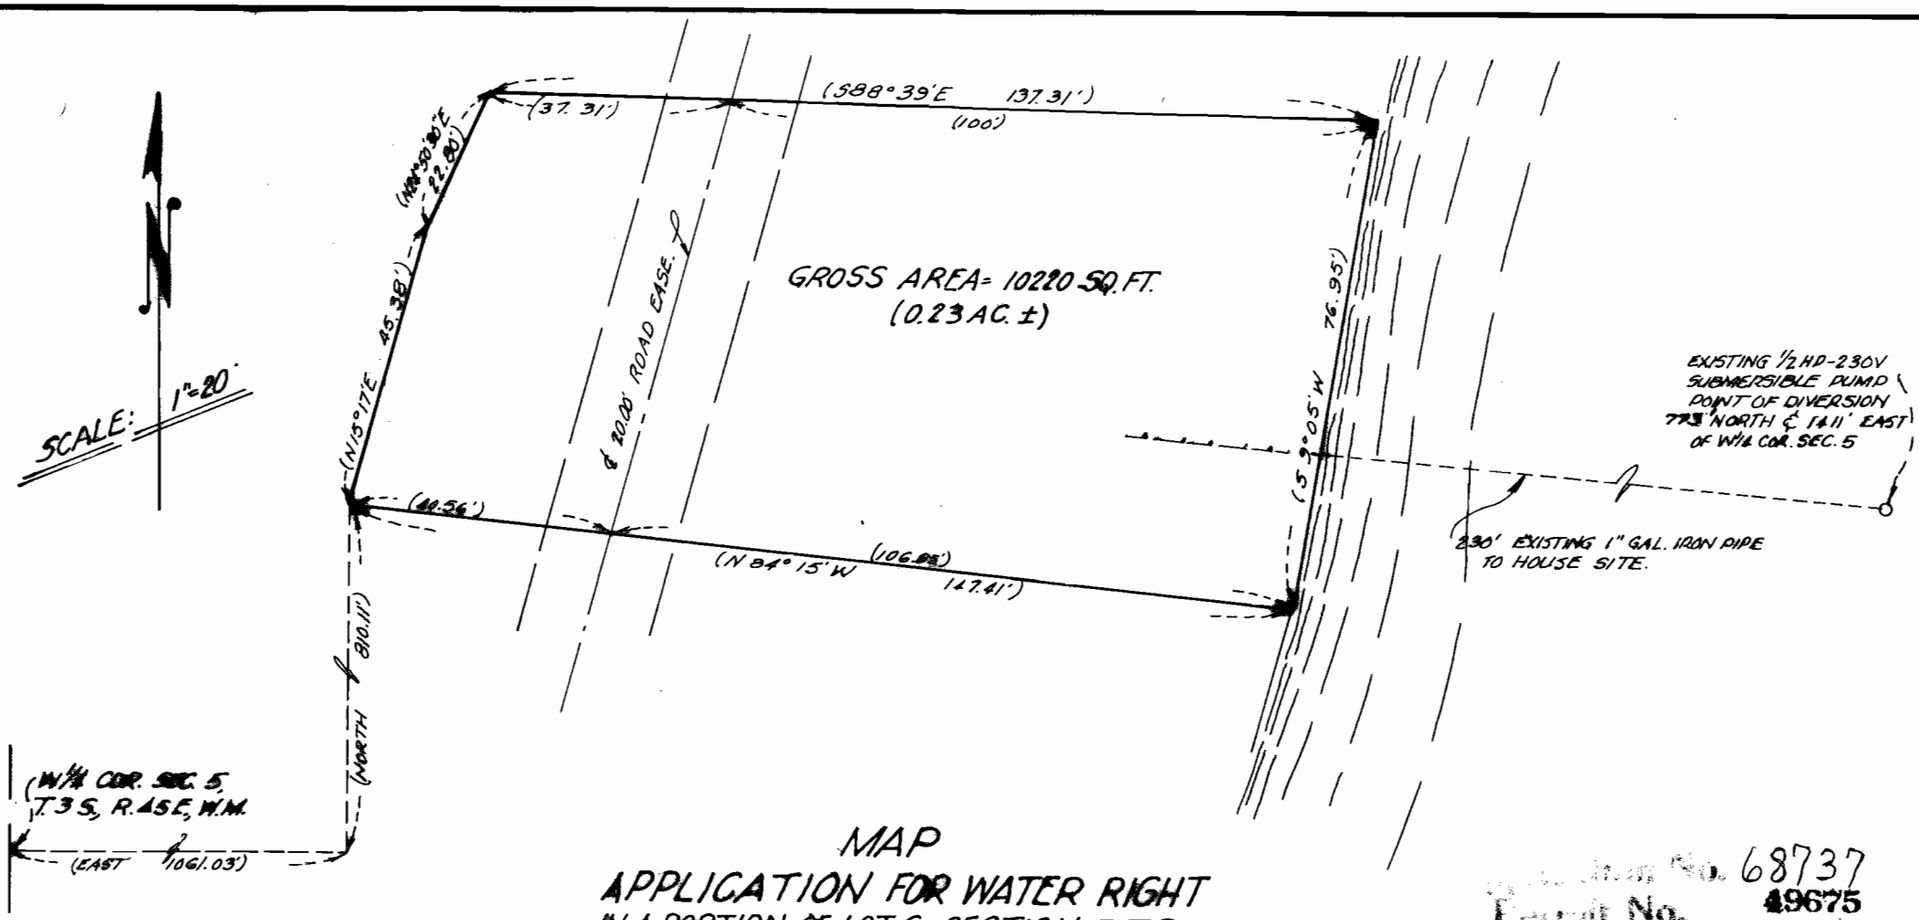

MAP
APPLICATION FOR WATER RIGHT

IN A PORTION OF LOT 6, SECTION 5, T.3S., R.45E, W.M., FORMERLY LOT 4 OF WALLOWA LAKE HEIGHTS - VACATED - SEE BOOK 78 PAGE 235 OF DEEDS.
(SEE TAX LOT 1400 - 3S-45-5)

Application No. 68737
Permit No. 49675

NOTE:
THIS MAP IS PREPARED FROM DATA OF RECORD AND THE LOCATION POD-IS DERIVED FROM INFORMATION SUPPLIED BY J. D. BAME, ELECTRICIAN, ENTERPRISE, OR.

REGISTERED PROFESSIONAL LAND SURVEYOR
Jack W. Burris
OREGON
JULY 14 1978
JACK W. BURRIS
1668

JACK BURRIS LAND SURVEYING
210 W. MAIN - P.O. BOX 63 - ENTERPRISE, OR 97828-426-4662

PREPARED AT REQUEST
DIANE COMDEN
JOSEPH, OR. 97846
P.O. BOX 816
(503) 426-4657

PREPARED BY
JACK W. BURRIS L.S. 1668
DATE: MAY 21, 1986 ACCT. NO. 85-13.