


A 7574-
P-4968

ROAD

ROAD

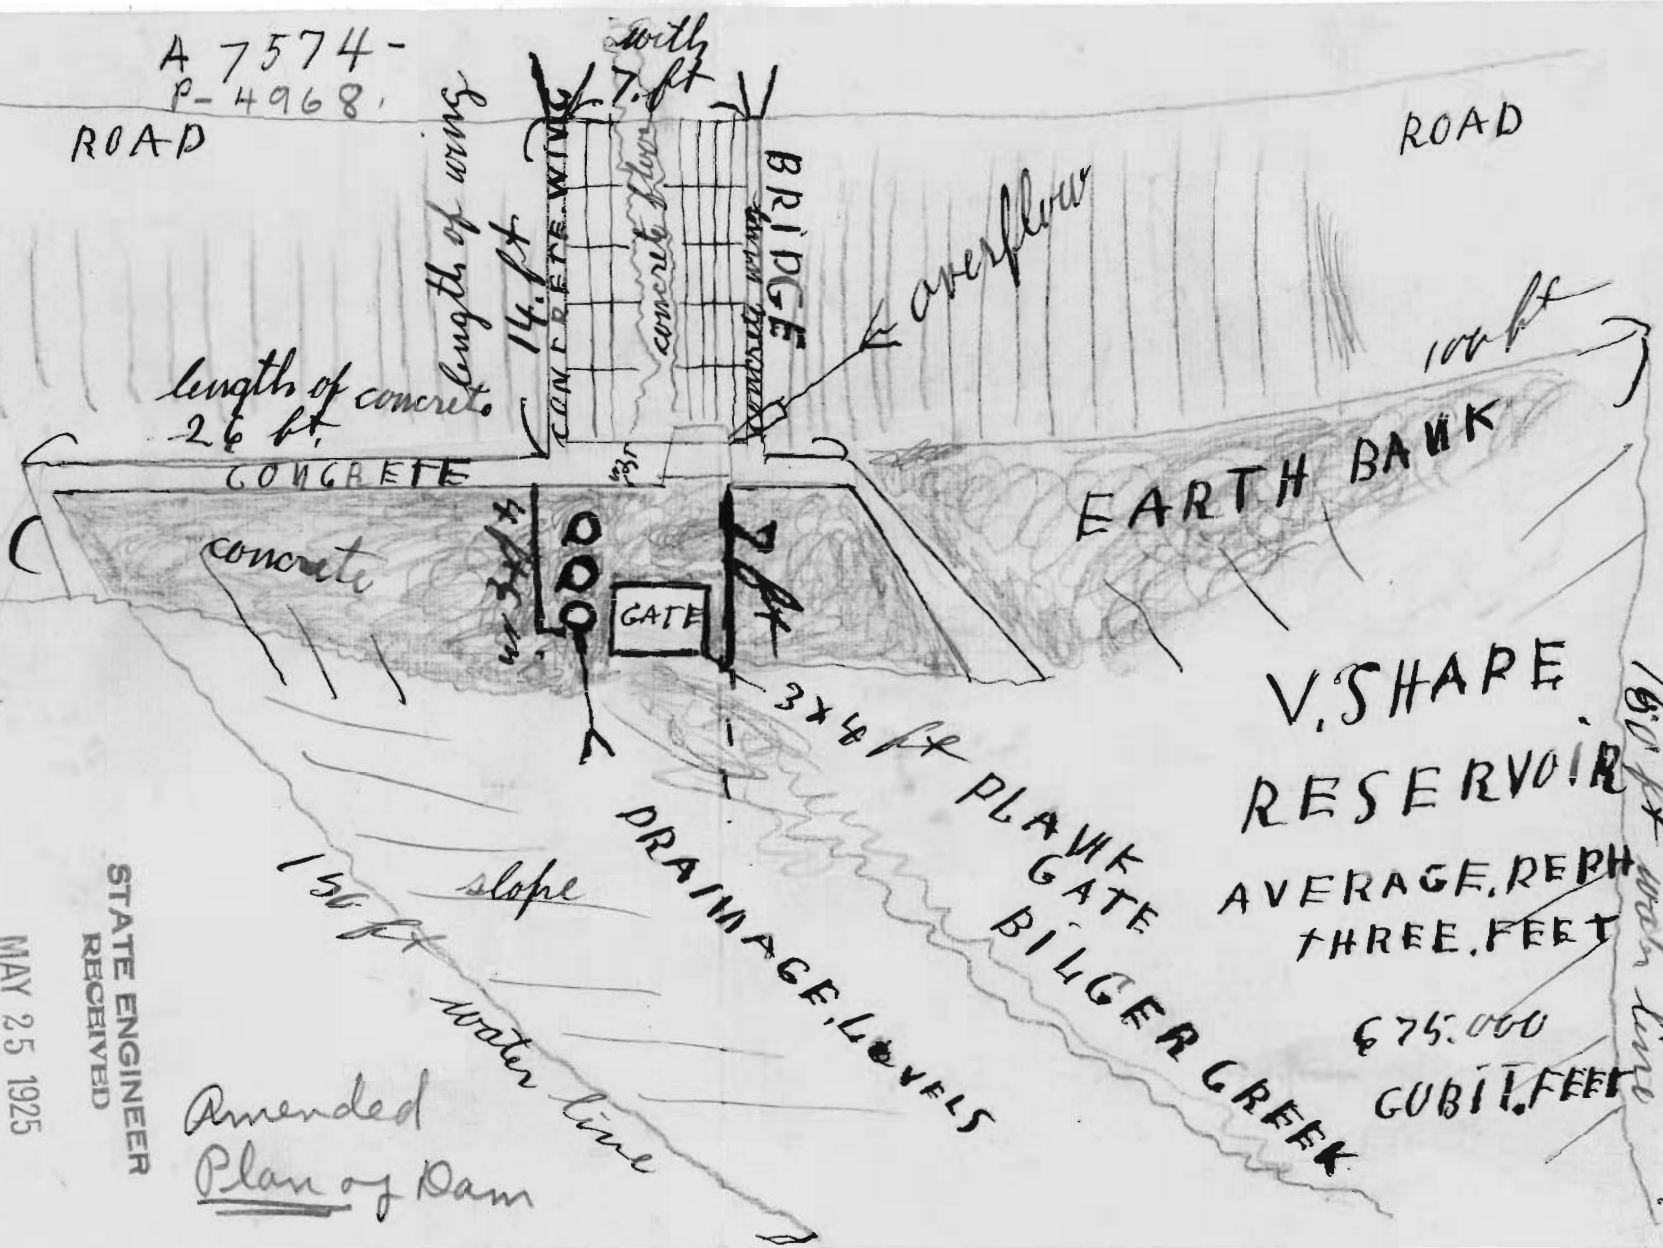

SALEM, OREGON



MAY 25 1925

STATE ENGINEER
RECEIVED

Amended
Plan of Dam

Township 28 S.,

Range 5 W.

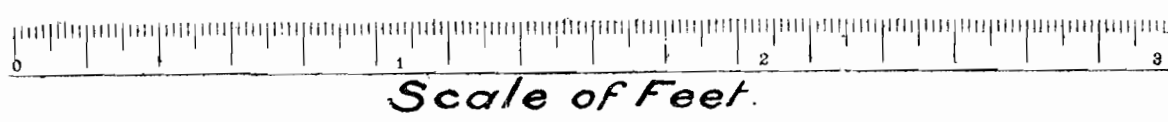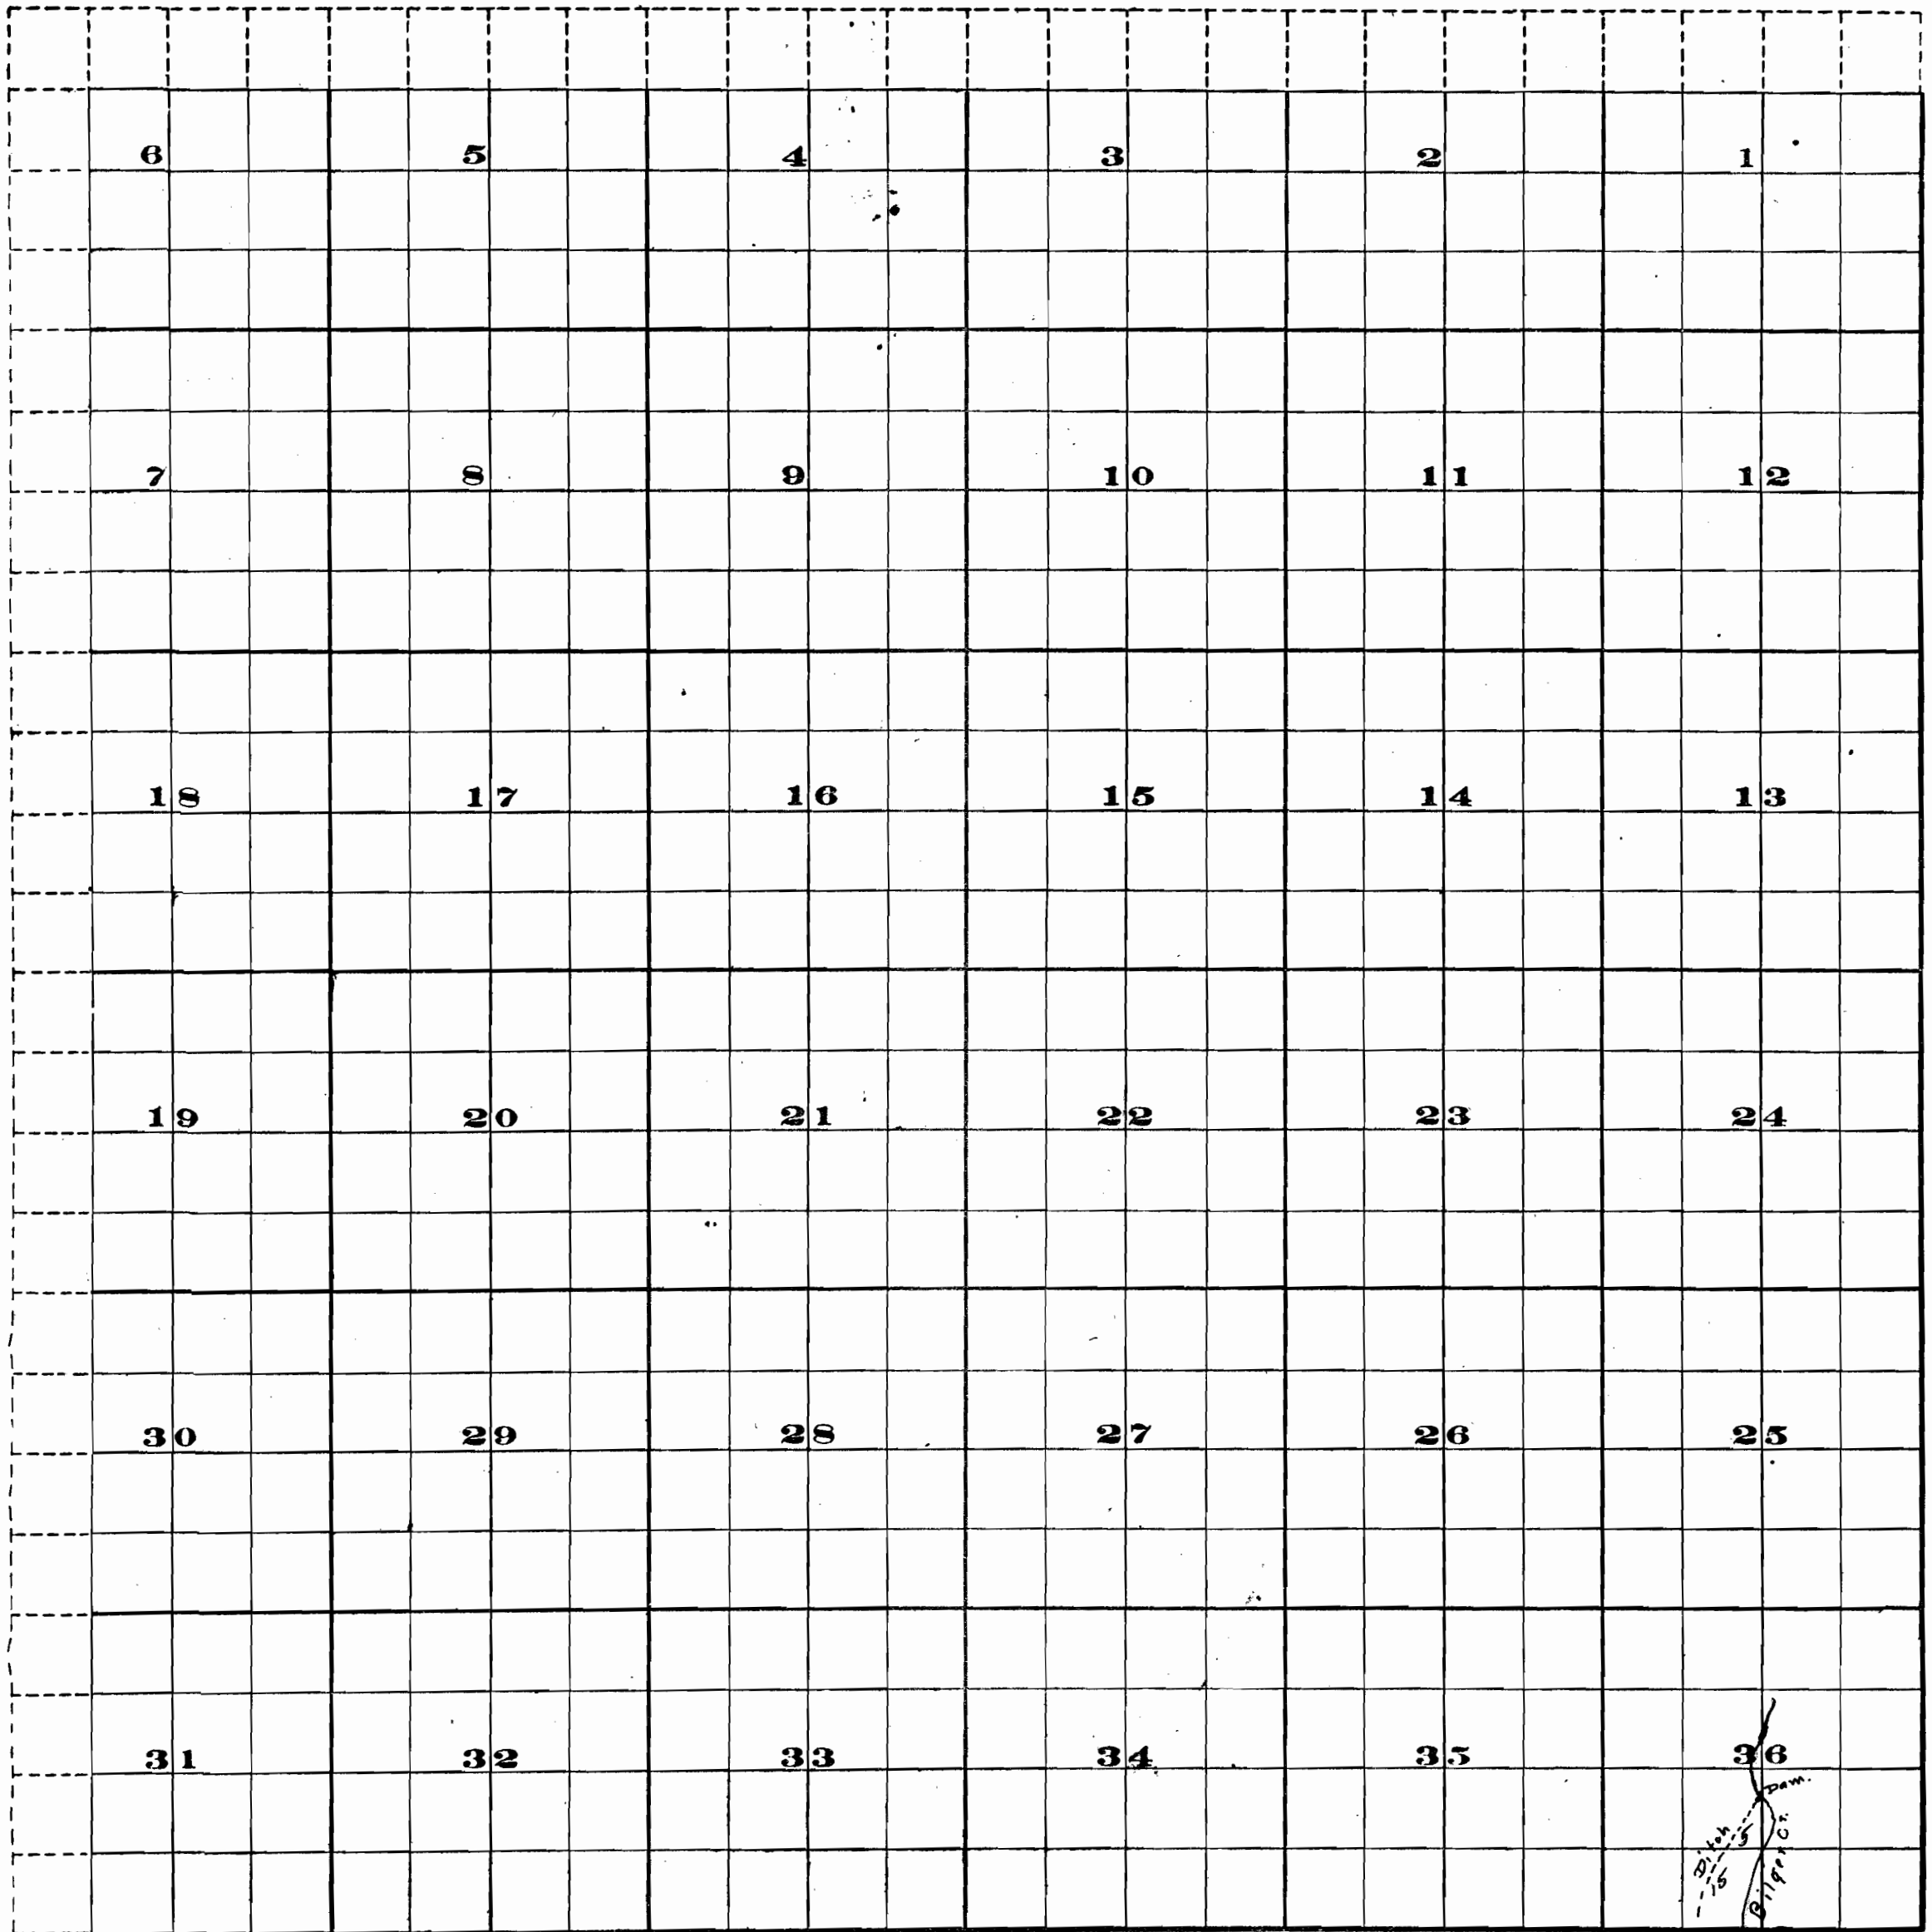

A-7574
P-4968

FROM OFFICE OF THE STATE ENGINEER, SALEM, OREGON

T 28 S R 5 W