


T. 3 & 4 S., R. 4 W., W.M.

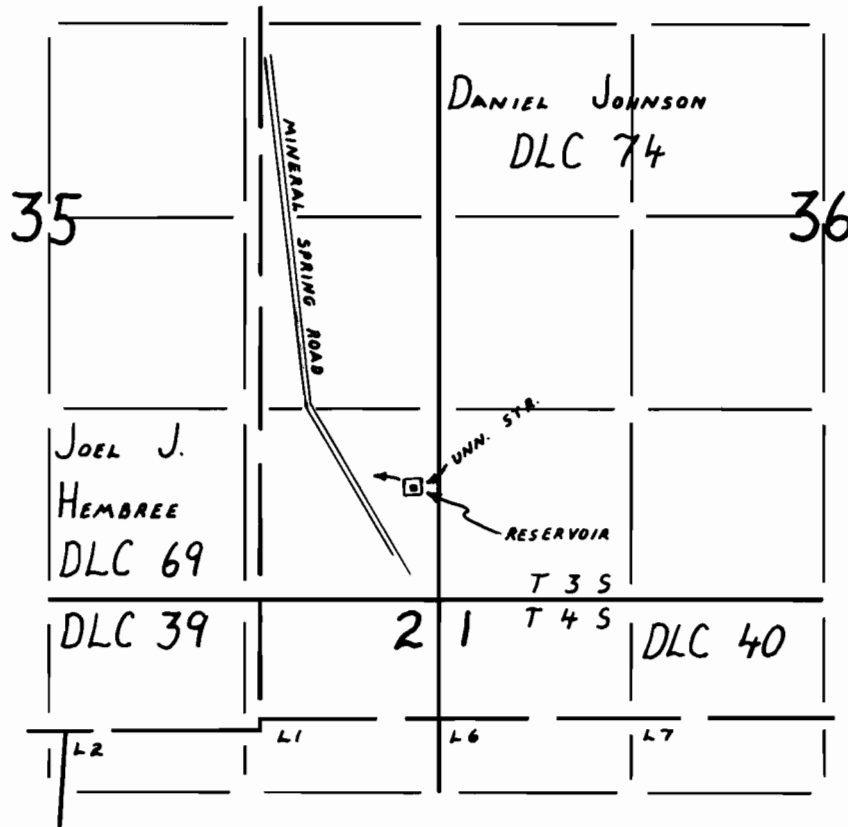

FINAL PROOF SURVEY

UNDER

Application No. R-68755, 68756 Permit No. R-10711, 49708
IN NAME OF

JEAN KESSEL

Surveyed FEBRUARY 27, 1991, by R.W. Klassen