


Permit: S 49829
Volume: 5B
Strm: A SPR
Trib: GRAVE CR
Priority: 9/29/86

T. 34 S., R. 5 W., W. M.

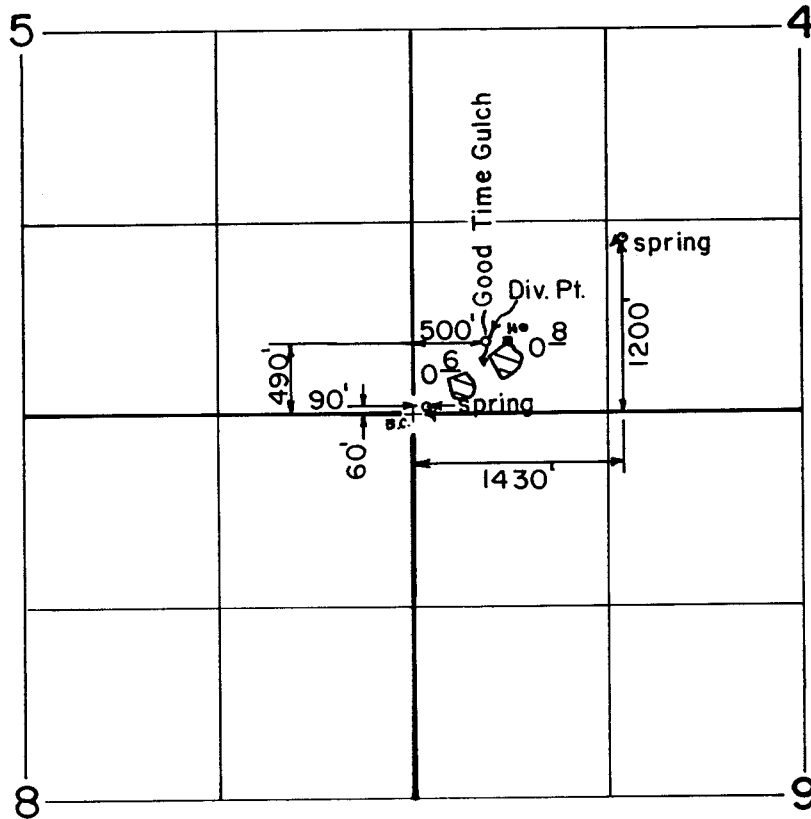

Scale: 1" = 1320'

FINAL PROOF SURVEY UNDER

60607 46468
Application No. 68928 Permit No. 49829...
IN NAME OF

.....LYNETTE.....GREGORY.....

Surveyed AUG..7... 19.90, by B..S..JAMES...

11033-179-1202
7/9/
LMS