
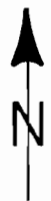


# T. 30 S., R. 5 W., W.M.

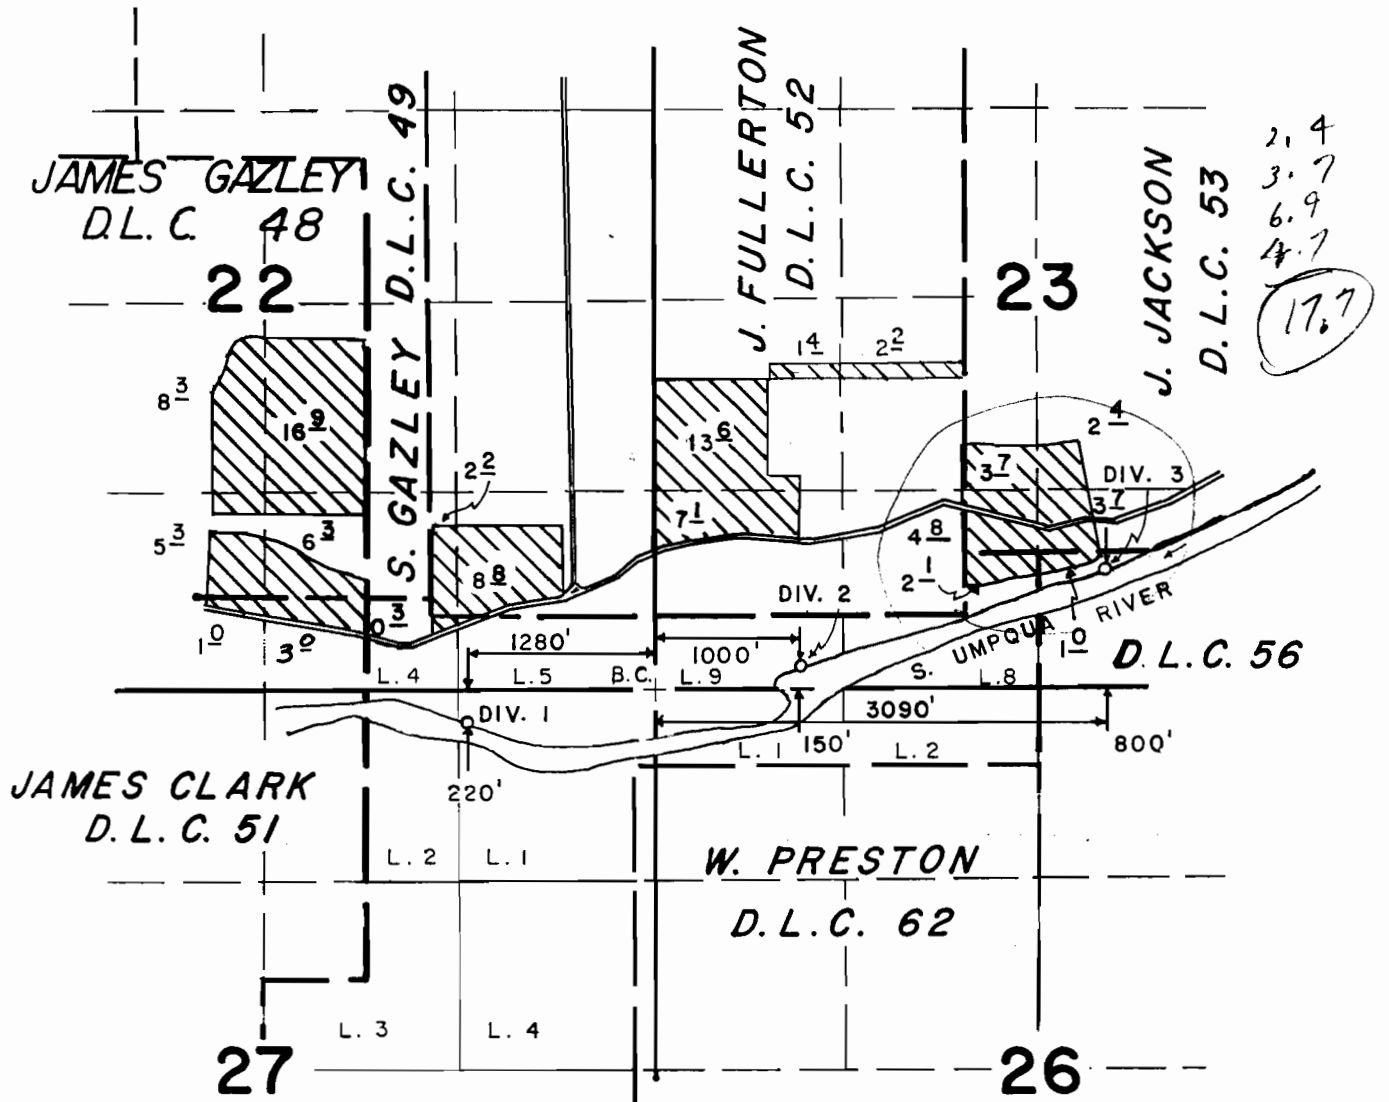

SCALE: 4" = 1 MILE

## FINAL PROOF SURVEY UNDER

Application No. 68258 Permit No. 49872  
IN NAME OF

**WEBSTER BRIGGS**

Surveyed APRIL 22 1987, by J.M. SCHMORDE