


34
Block 4

Permit: S 49874
Volume: 1A
Strm: SOUTH FORK ROCKY G
Trib: ROGUE R
Priority: 11/13/86

T. 34 S., R. 8 W., W.

WATER RESOURCES DEPT.
SALEM, OREGON

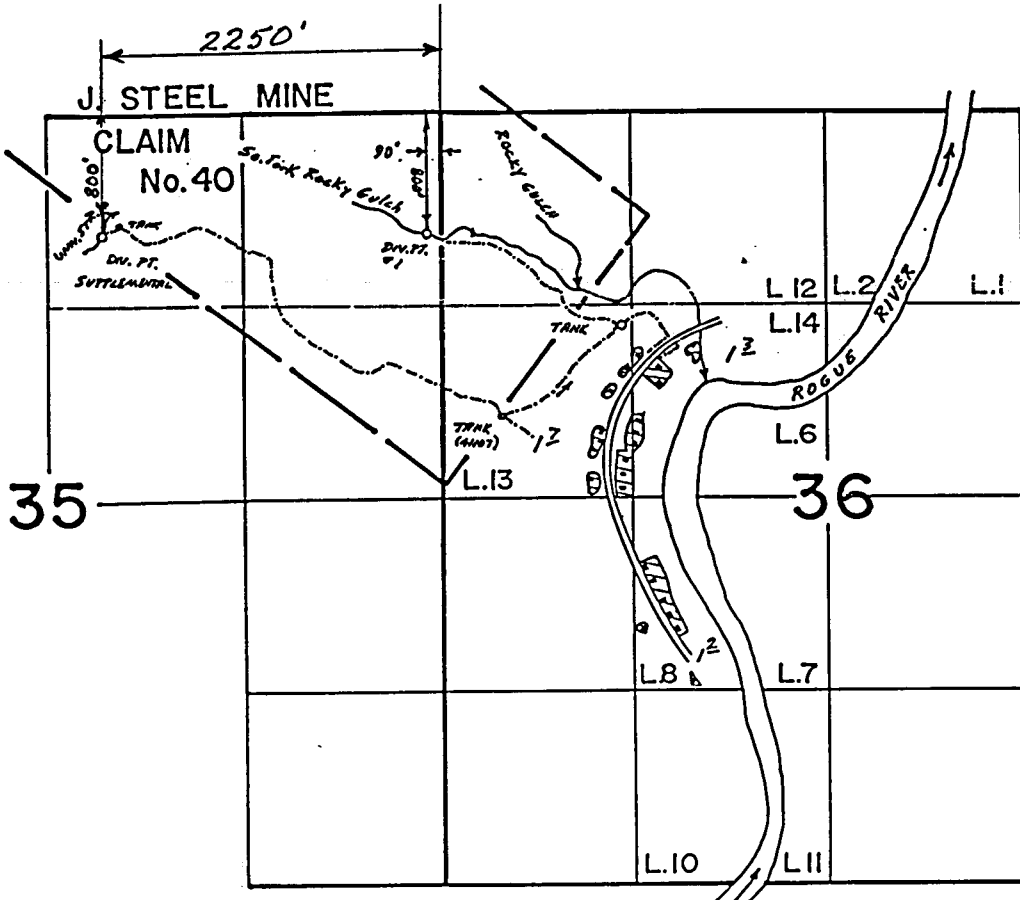

RECEIVED

NOV 25 1986

WATER RESOURCES DEPT.
SALEM, OREGON

RECEIVED

FEB 25 1987

WM. DIST. 14
GRANTS PASS, OREG.

Scale 1"=1320'

Application No. 68586
Permit No. 49874

Land upon which water used more explicitly described as:

- Homesites — (Block 1 - Lots 7, 8, 10, and 11)
- (Block 2 - Lots 3, 5, 6, 7, 8, 10, and 14)
- (Block 3 - Lots 3, 4, 5, 6, 8, 10, and 11)

- Camp trailer sites — (Block 2 - Lots 4, 11)
- (Block 4 - Lot 8)

Sites above presently covered by use from So. Fk. Rocky Gulch (Per. 40733) and to be covered by secondary supply from unnamed stream

Sites below to be covered by primary supply from So. Fk. Rocky Gulch and secondary supply from unnamed stream

- Homesites — (Block 1 - Lot 6)
- (Block 4 - Lot 4)