



RECEIVED


SEP 16 1986

WATER RESOURCES DEPT
SALEM, OREGON

T.2&3N.R.12E.W.M.

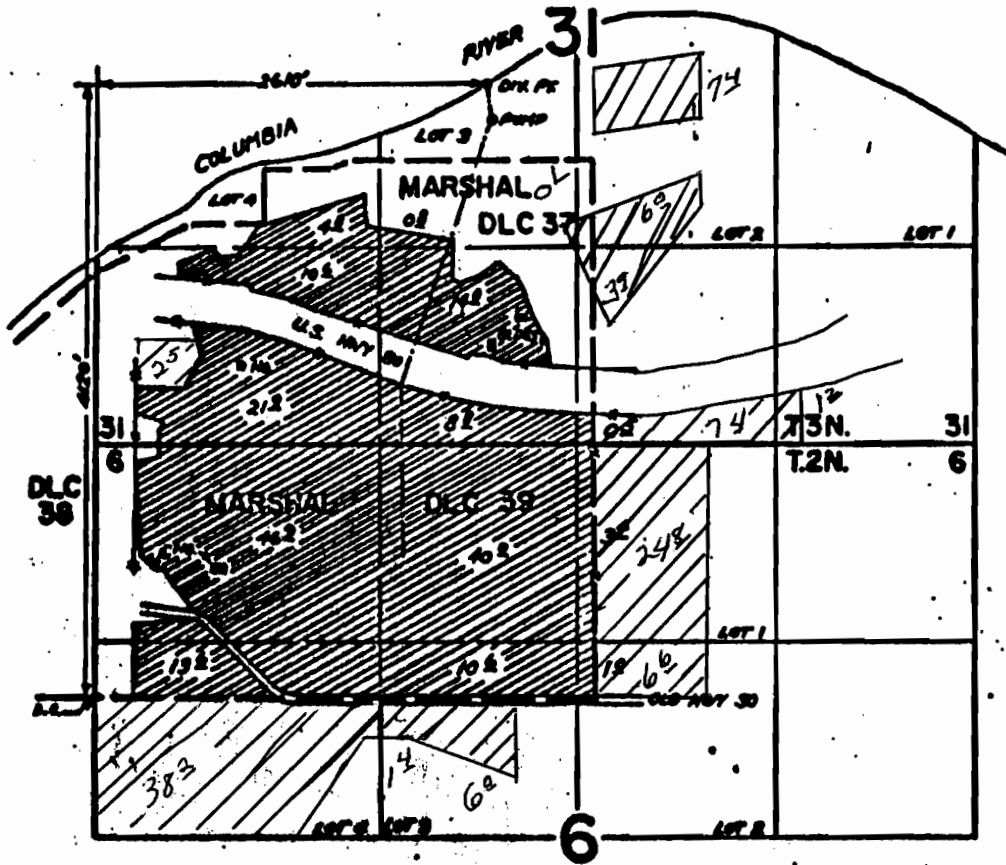

Existing water rights in
dark  lines.

New application rights in black
ink  lines

Revised map of
Application No. 68813
Permit No. 49906

Wilson Bros. Farms
P.O. Box 246
Mosier, Oregon 97040