


RECEIVED

OCT 7 1980

WATER RESOURCES DEPT.
SALEM, OREGON

P.O.D.
90' N. & 296'
W. FROM THE
W.E. COR. OF
ISAAC LEMASTERS
D.L.C.
BEING WITHIN
SW 1/4 NW 1/4 NW 1/4
OF SEC. 1

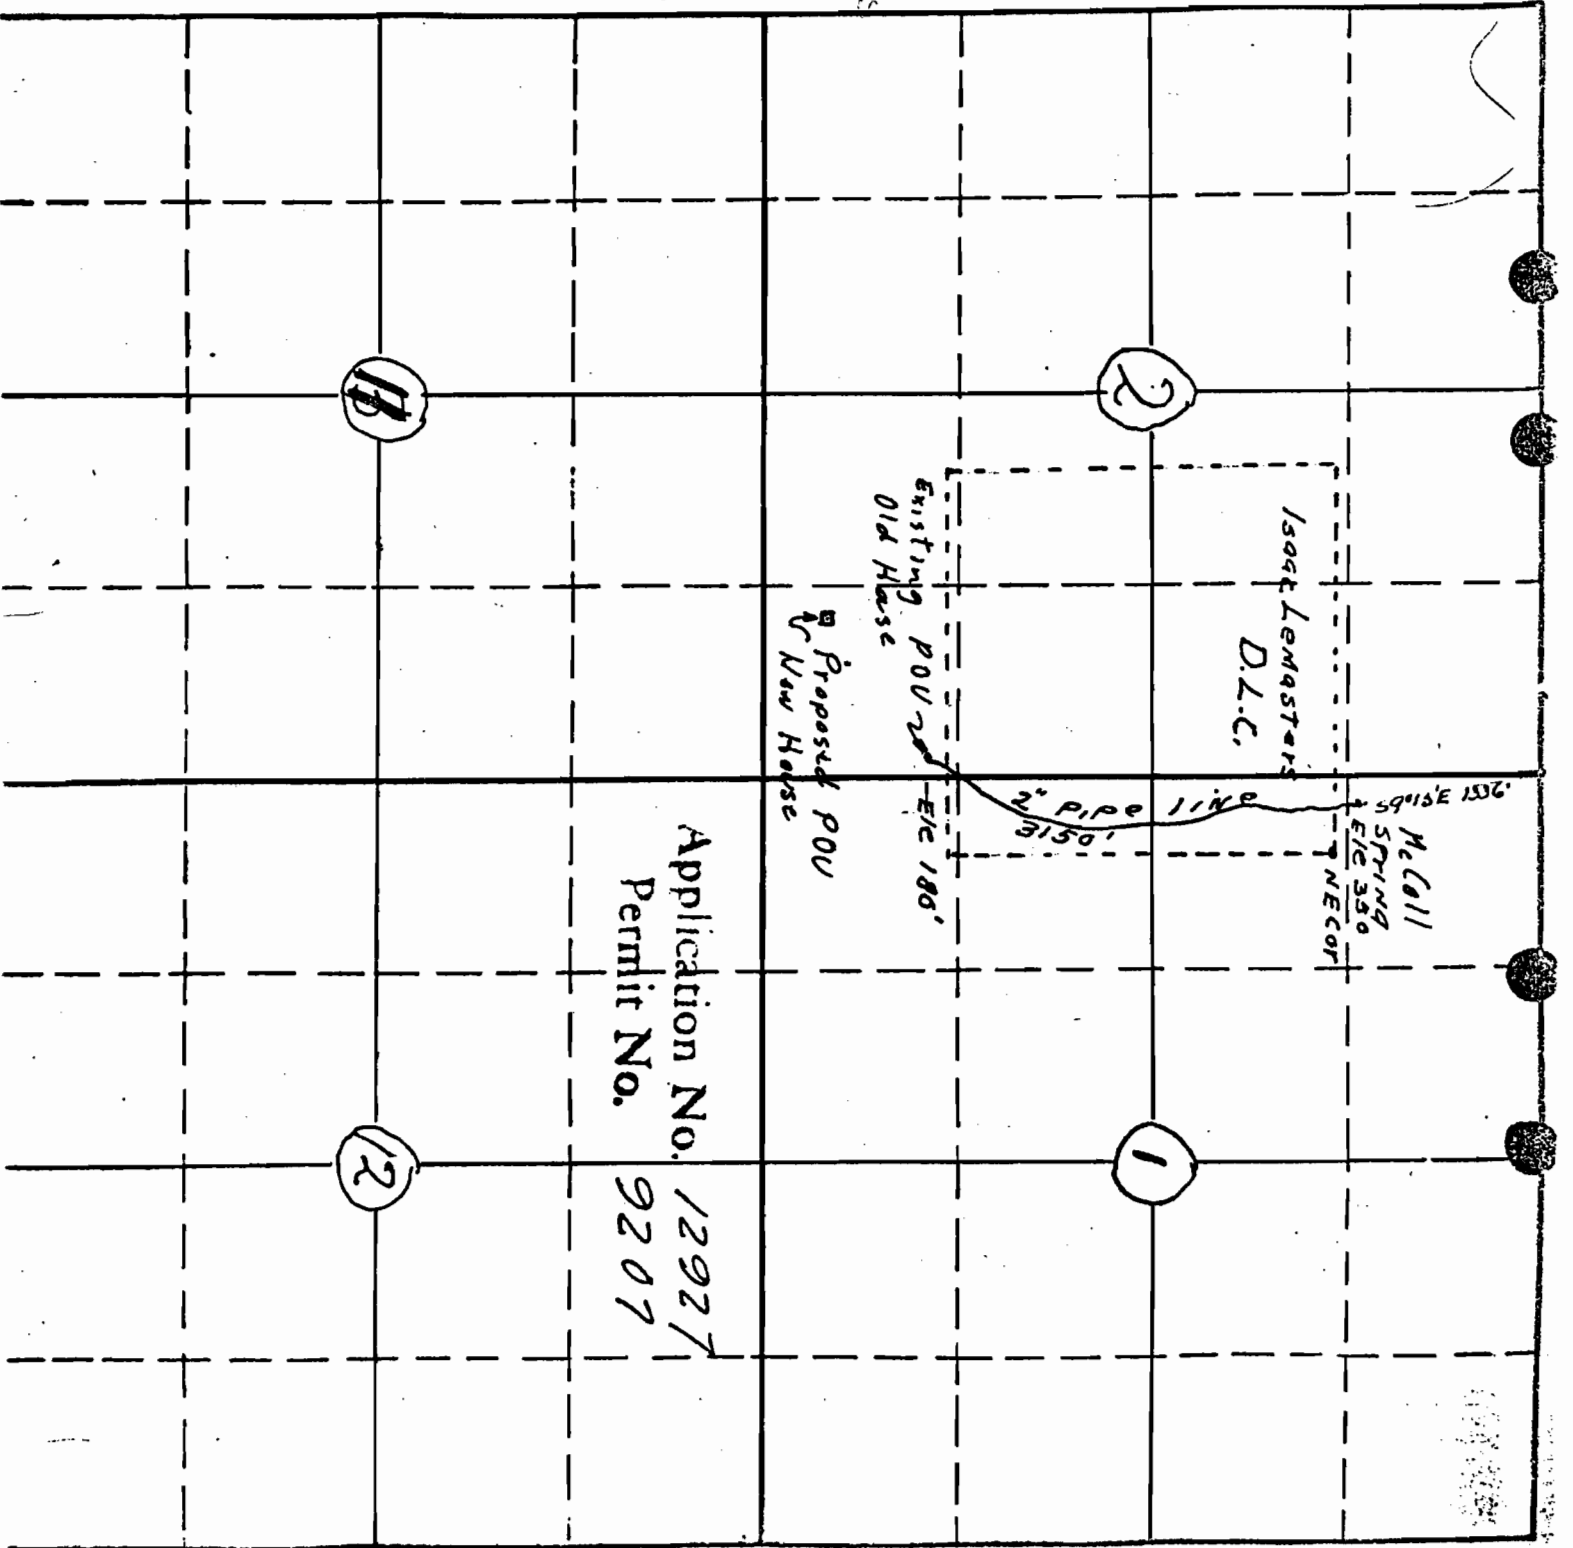

Application No. 12927
Permit No. 9207

Sec. 4
Tp. 4
R. 5

1026