


CERTIFICATE OF SURVEYOR

I, John E. Johnson, of Vale, Oregon, do hereby certify that this map was made, partly from notes taken during an actual survey made by me, and partly from data furnished by applicant, and that it correctly represents the works described in the accompanying application, together with the location of streams and other ditches in the immediate vicinity. February 16, 1921.


John E. Johnson  
Surveyor.

Application No. 7761  
 Dec. 1920 No. 502  
 Application No. 7762  
 Permit No. 4996

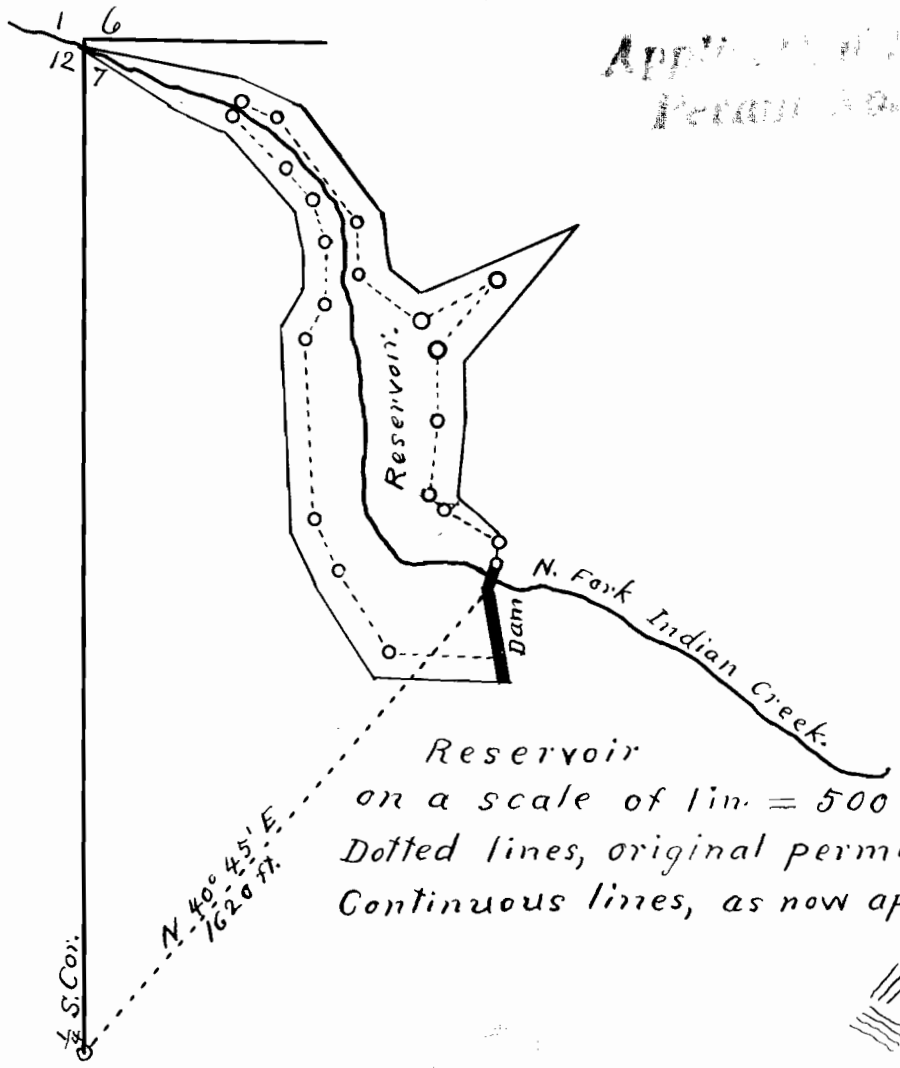

Reservoir  
 on a scale of 1 in. = 500 ft.  
 Dotted lines, original permit.  
 Continuous lines, as now applied for.

Legend:  
 Present water right  
 Application for full water right

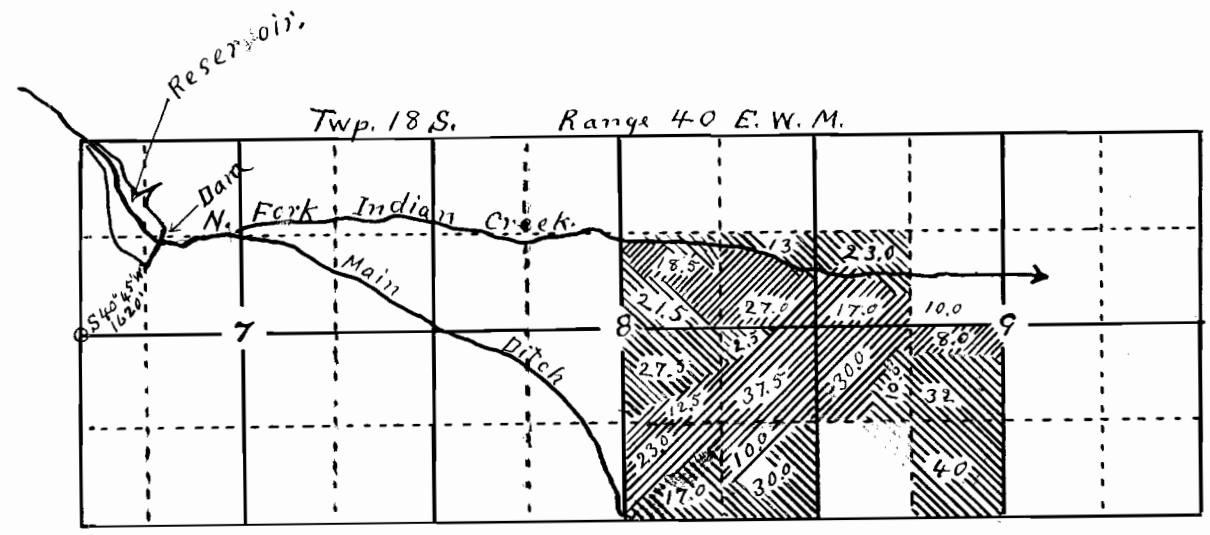

MAP

Accompanying application for permit  
 to appropriate water  
 Charles Becker  
 Feb. 16, 1921.

Scale 2 in = 1 mi.