


T. 36 S., R. 5 W., W. M.

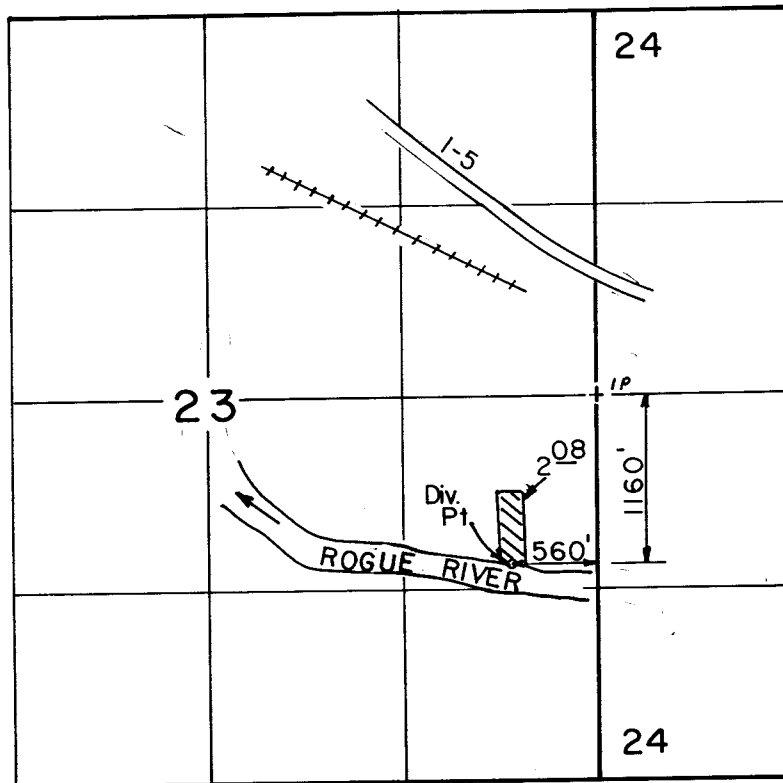

Scale: 1" = 1320'

RECEIVED

AUG 26 1991

WM. DIST. 14
GRANTS PASS, ORE.

FINAL PROOF SURVEY UNDER

Application No. 68971 Permit No. 49970
IN NAME OF

KARYL.....MORT.....&.....BEVERLY.....PETERSON

Surveyed OCT. 3, 1990, by L. M. JOACHIMS