


# T. 3 S., R. 1 E., W.M.

## SECTION 13

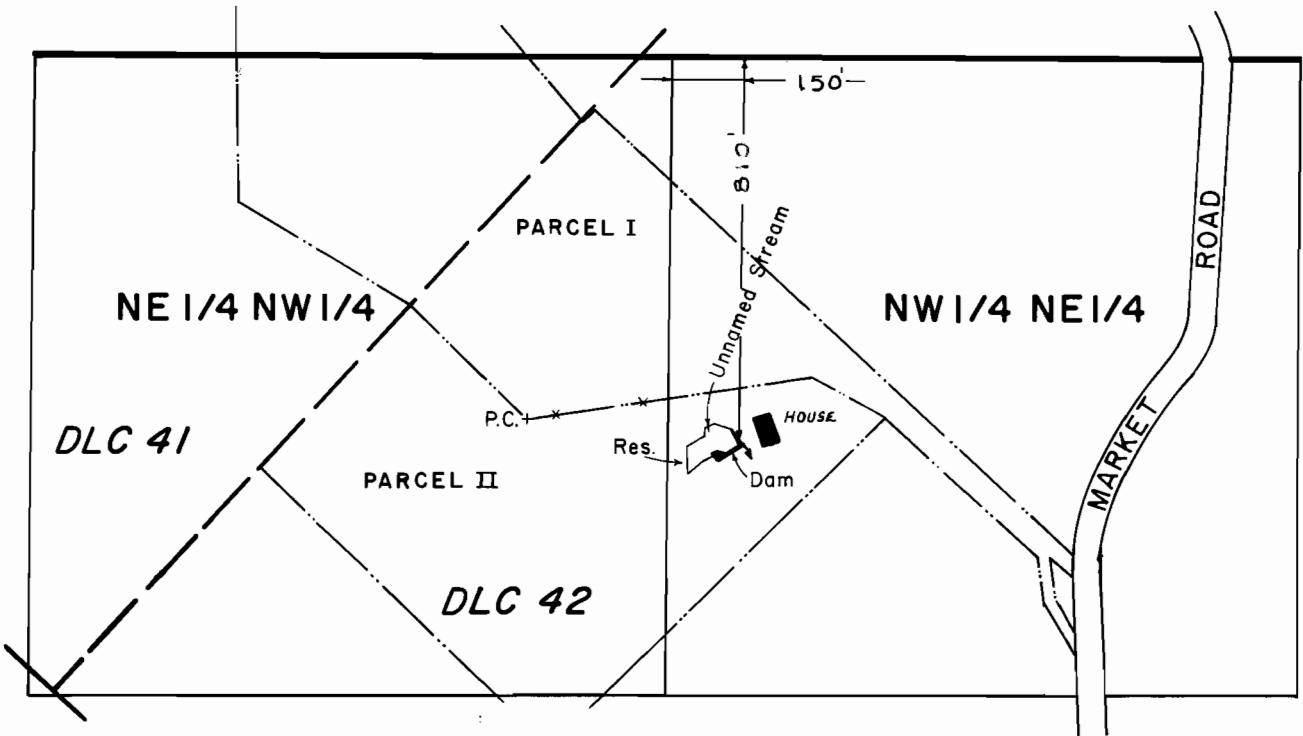

SCALE: 1" = 400'

### FINAL PROOF SURVEY UNDER

R-69021

R-10825

Application No. 69022. Permit No. 49976....

IN NAME OF

ROBERT JAMES LOFGREN

Surveyed APRIL 1 91, by R. W. KLASSEN  
MAY 15, 1990., by T. M. WARREN

6-15-90

PTS

REVISED 2/93 RWK