

BOB'S

PLUTO'S PROMENADE

CAMP

1/4" BLACK PLASTIC

Point of Diversion
600' N and
675' E of
Center section corner,
Sec 26, T₁₉S, R₁₂W

LAKE

TSILTCOOS

See Map 19 12 25

097-02


Application No. 68995

Permit No. 49982

Application No. 68995
 Permit No. 49982


BIG ANNIE LANE

TRAIL

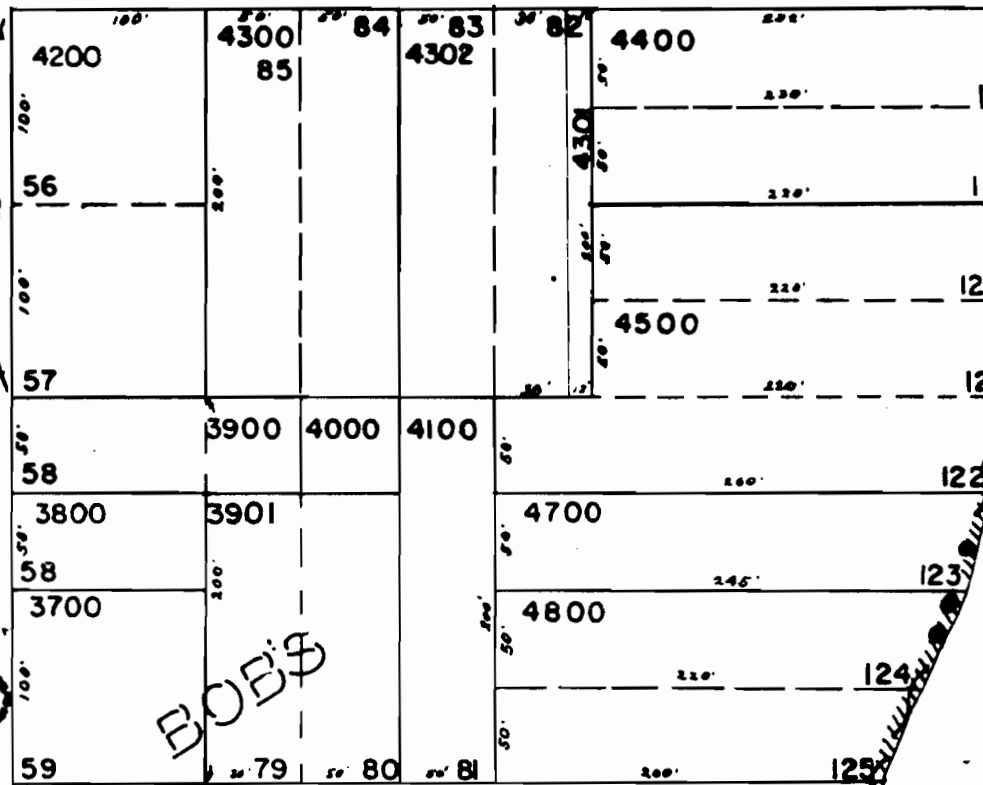

PLUTO'S PROMENADE

09

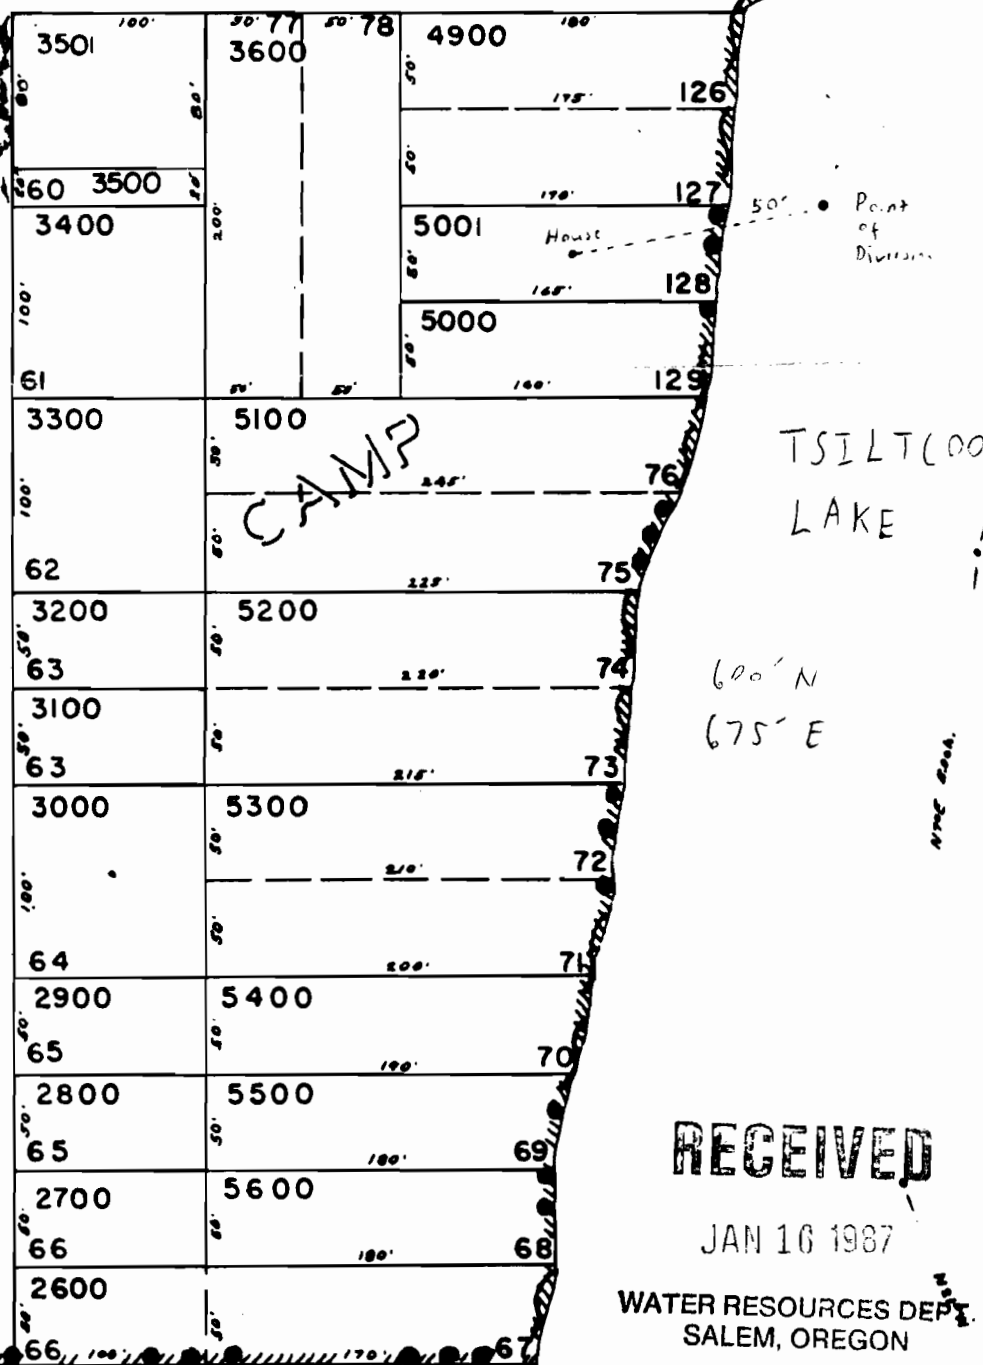

HELKAT

BUCKSKIN

BOB'S

TSILTCOO
LAKE

600' N
675' E

RECEIVED

JAN 16 1987

WATER RESOURCES DEPT.
SALEM, OREGON

RECEIVED

FEB - 2 1987

WATER RESOURCES DEPT.
SALEM, OREGON

ent. Sec.
11/29/87
2012
Map Attach
Cover

Volume 4, Page 54,
Lane County Oregon Plat Records See Map 19 12 26 4

1" = 100'

