


1" = 100'
SEE MAP 36 5 20AB

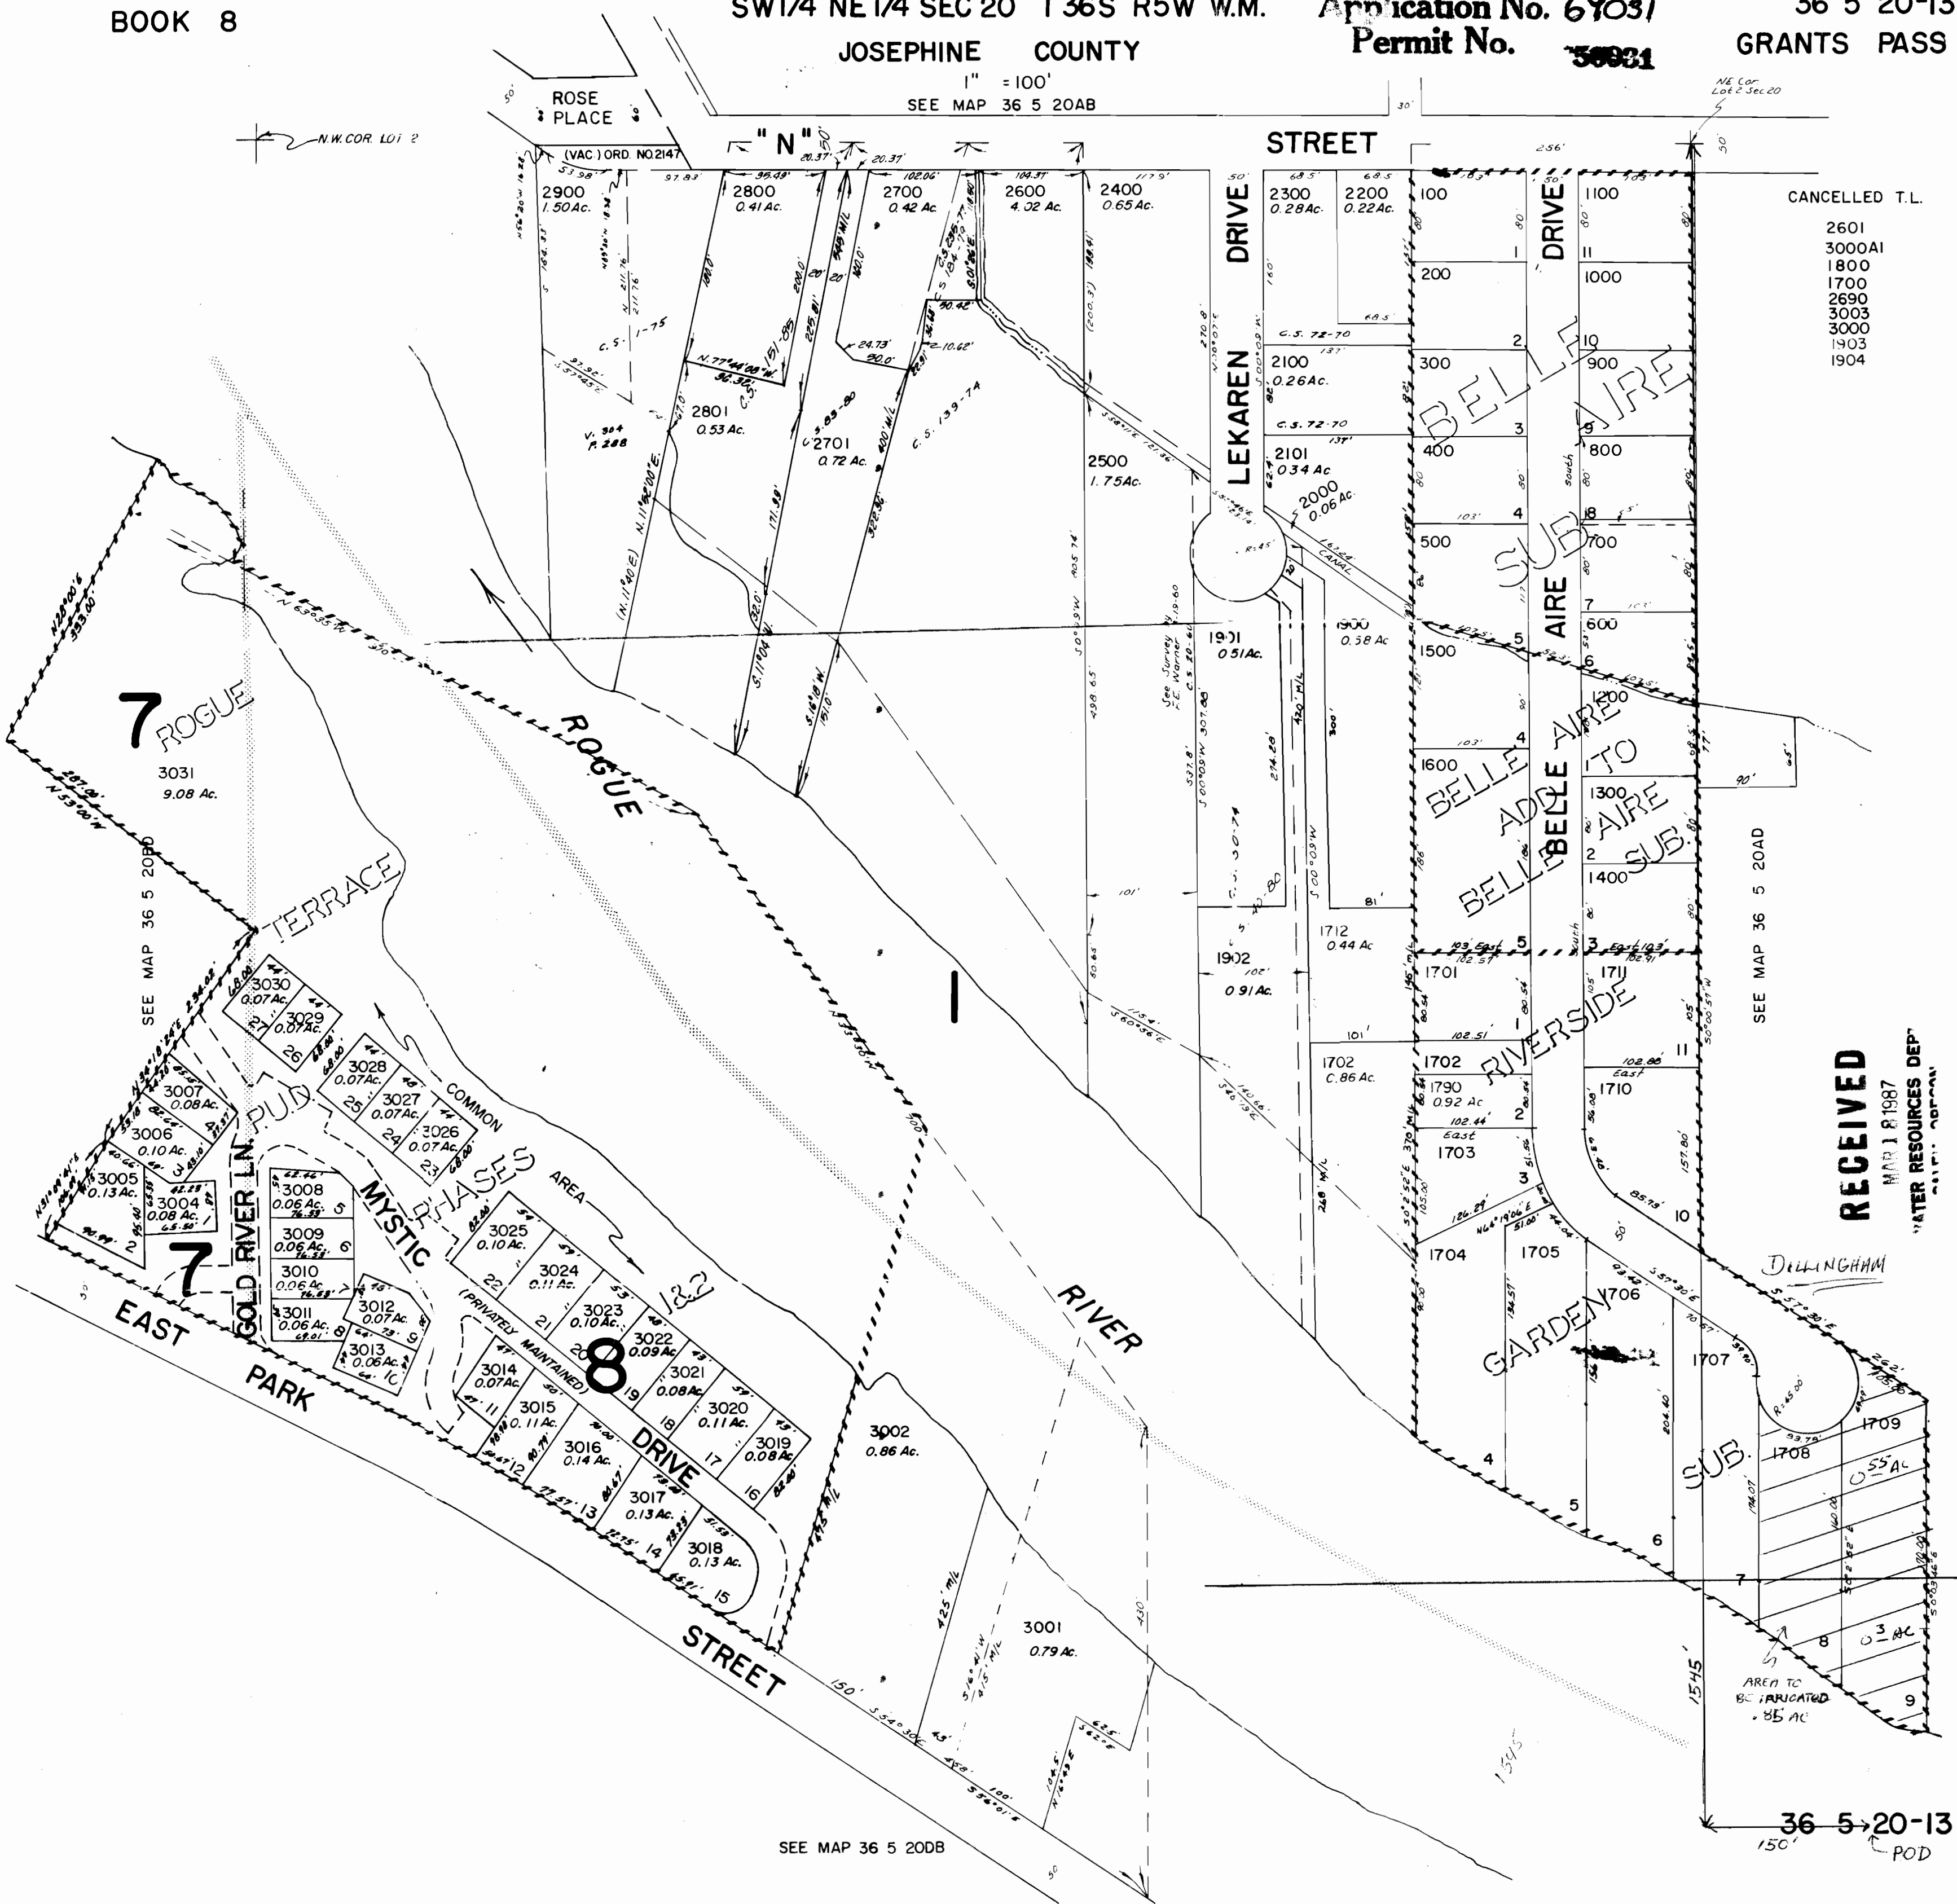

CANCELLED T.L.

2601
3000AI
1800
1700
2690
3003
3000
1903
1904

RECEIVED

MAR 18 1987

WATER RESOURCES DEP.