


1. 25. R. 4 E W. 111
 Scale 4" = 1 mile

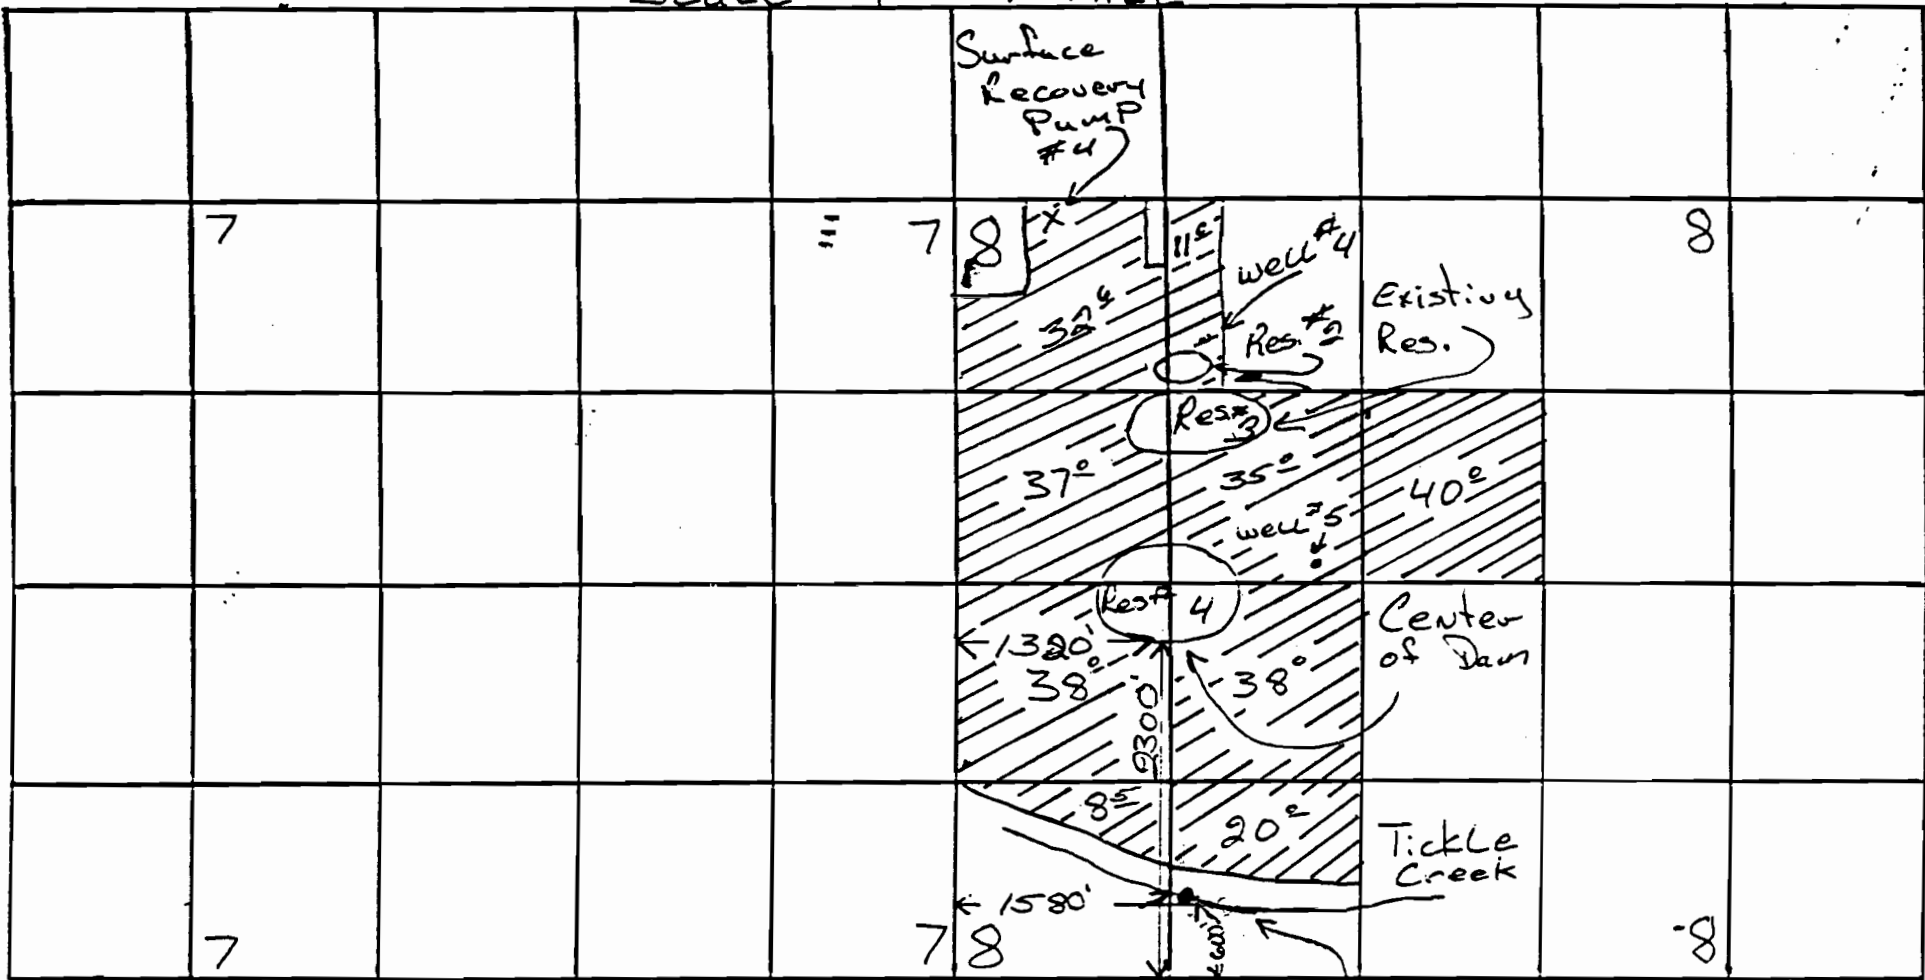

D.u. AT Tickle Creek

600' N & 1580' E. From S.W. Corner
 Sec. 2 T2E. R4E

Diversion Point

Application No. R-69175 & 69176

Permit No. R10837

50048