
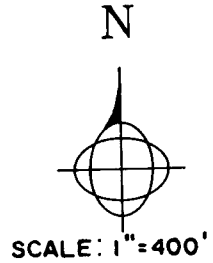


Permit: S 50073
 Volume: 6
 Strm: APPLEGATE R
 Trib: ROGUE R
 Priority: 6/04/87

T.37S.,R.6W.,W.M.
 SECTION 15

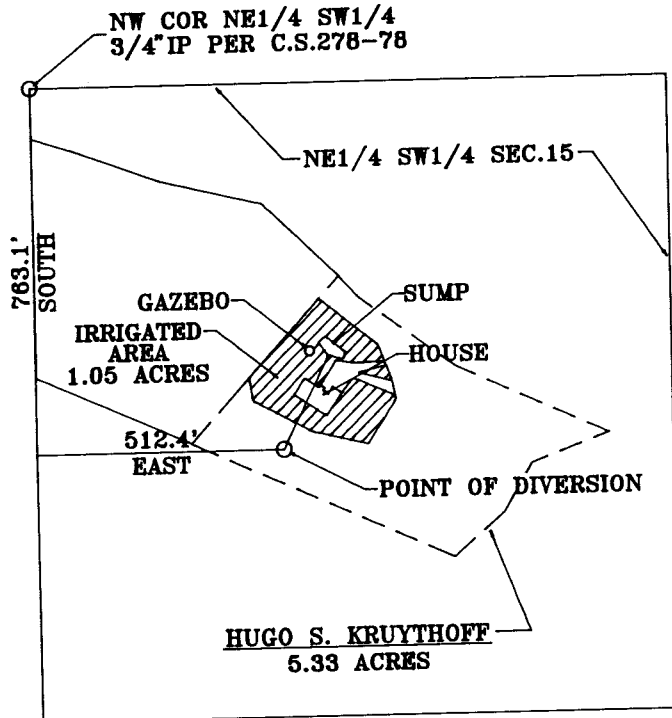


FINAL PROOF SURVEY
 UNDER

Application No.69123, Permit No.50073
 IN NAME OF

HUGO S. KRUYTHOFF

Surveyed Aug. 19, 1991, by MAAKESTAD & ASSOCIATES, INC.

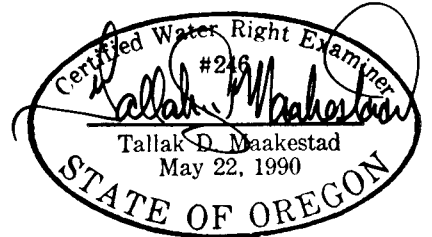

MAAKESTAD
& ASSOCIATES, INC.

SURVEYING * MAPPING * PLANNING
 * WATER RIGHTS *

303 N.E. "E" STREET, GRANTS PASS, OR 97526 (503)471-1113

JOB #: 91-06
 DATE: 09/24/91

PREPARED FOR: HUGO KRUYTHOFF
 P.O. BOX 1241
 GRANTS PASS, OR 97526

SHEET
 1 OF 1