


Application No. 69127
Permit No. 50074



T. 29 S. R. 6 W S. 16

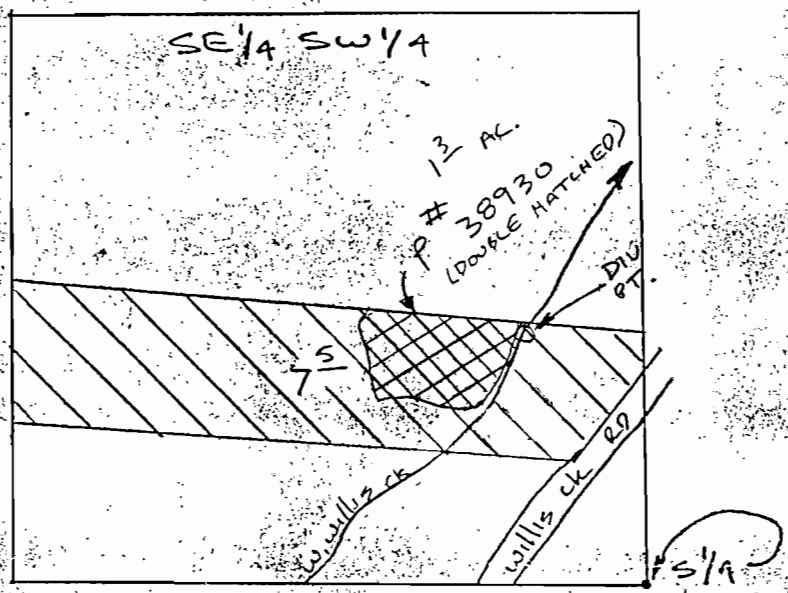


DIV. PT. = 520 N. & 250 W S. 16
From S 1/4 S. 16

Application No. 69127
Permit No. 50074

RECEIVED
JUL 8 - 1987
WATER RESOURCES DEPT.
SALEM, OREGON



T. 29 S. R. 6 W. S. 16

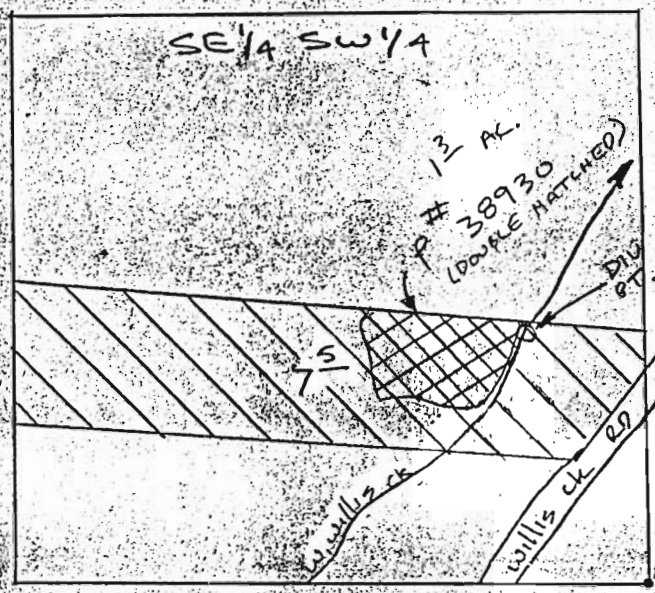

DIV. PT. = 520 N. & 250 W. S. 16
From S 1/4 S. 16