

RECEIVED


SEP 18 1987

WATER RESOURCES DEPT.
SALEM, OREGON

RECEIVED

DEC 7 8 1987

WATER RESOURCES DEPT.
SALEM, OREGON

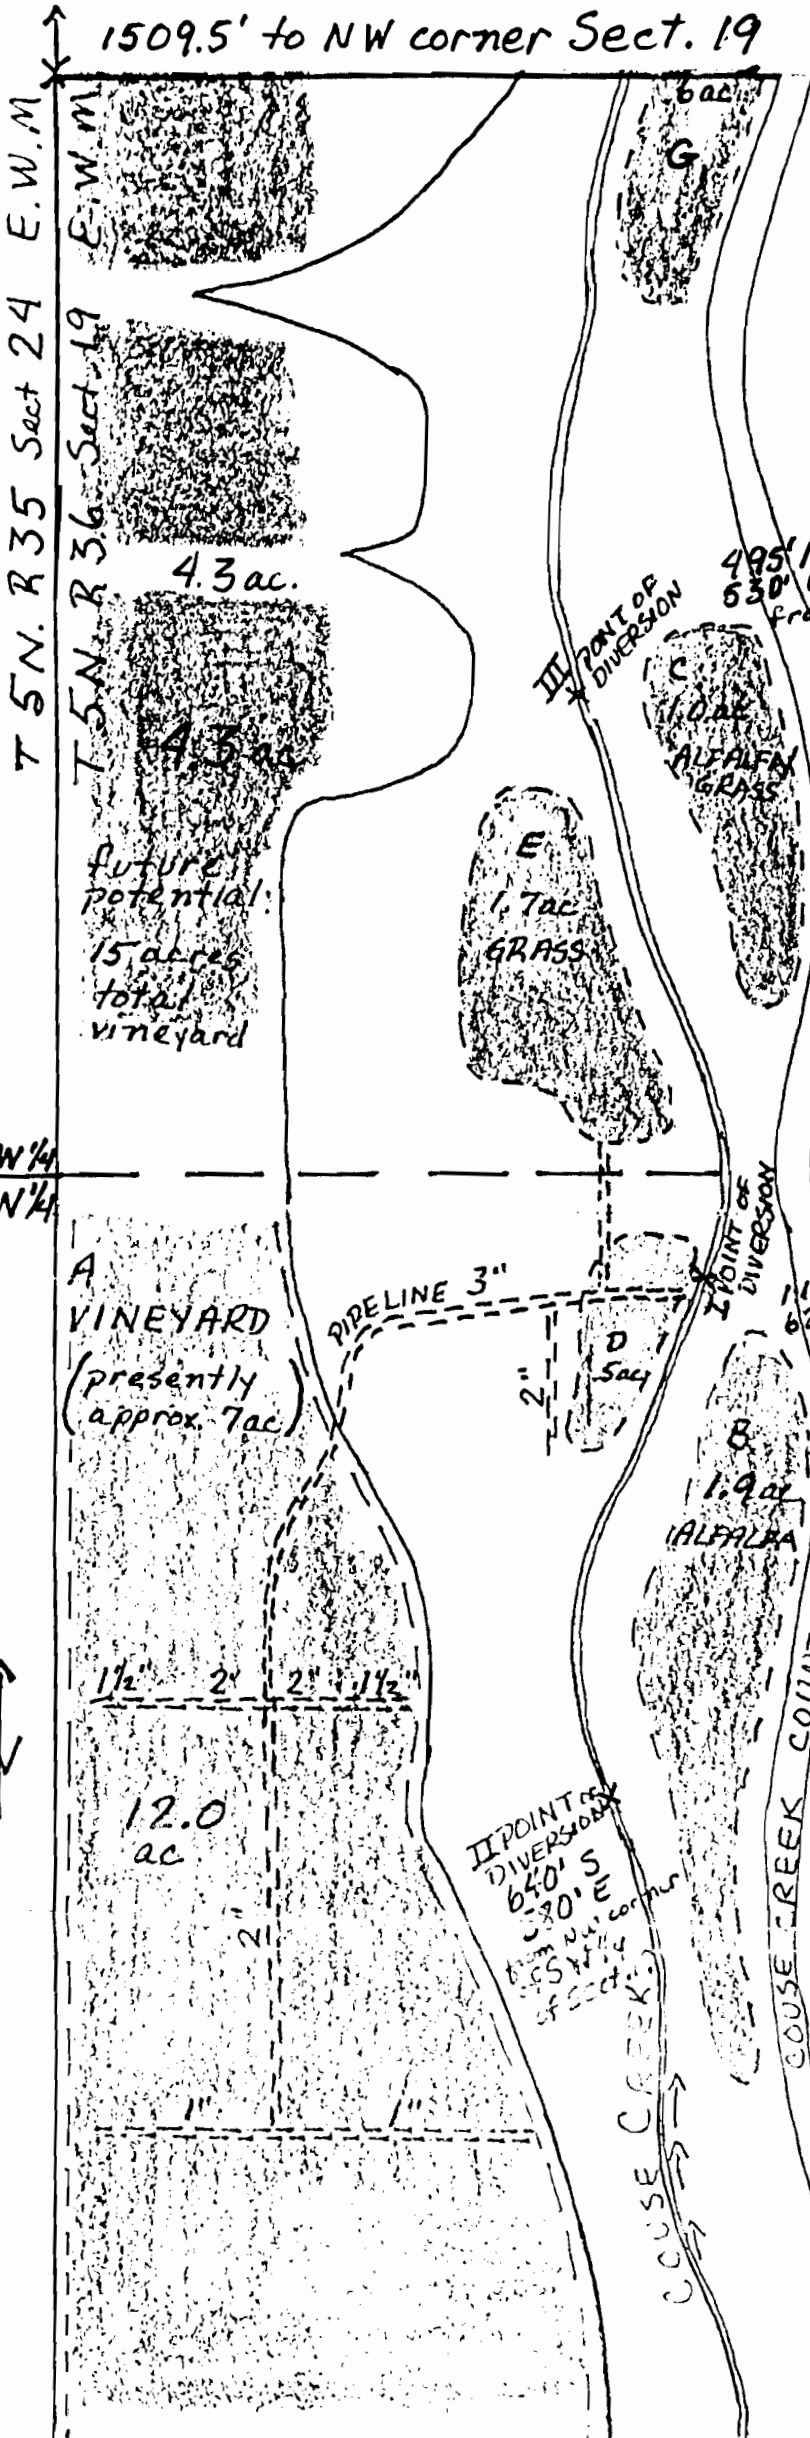

Application No. 69183
Permit No. 50170

7.6 acres to be irrigated

SW 1/4 NW 1/4

NW 1/4 SW 1/4

14.4 acres to be irrigated