



RECEIVED

NOV 26 1987
WATER RESOURCES DEPT
SALMON, OREGON

T. 33 S., R. 2 E., W.M.

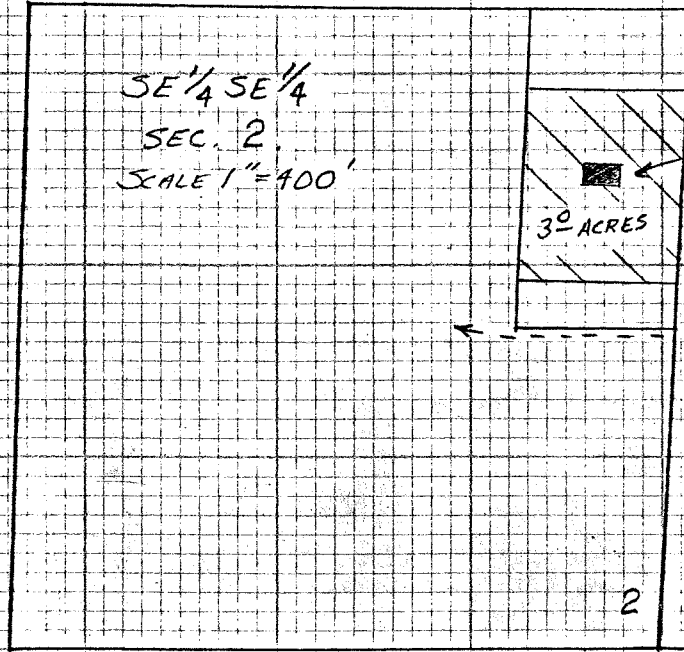

T. 32 S., R. 3 E., W.M.

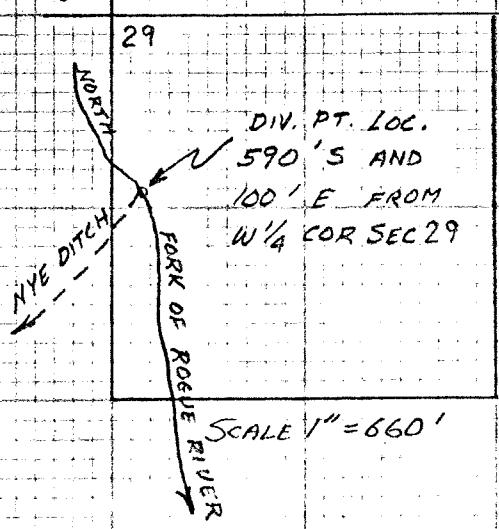

Application No. 69490
Permit No. 50242