


T. 37 S., R. 5 W., W. M.

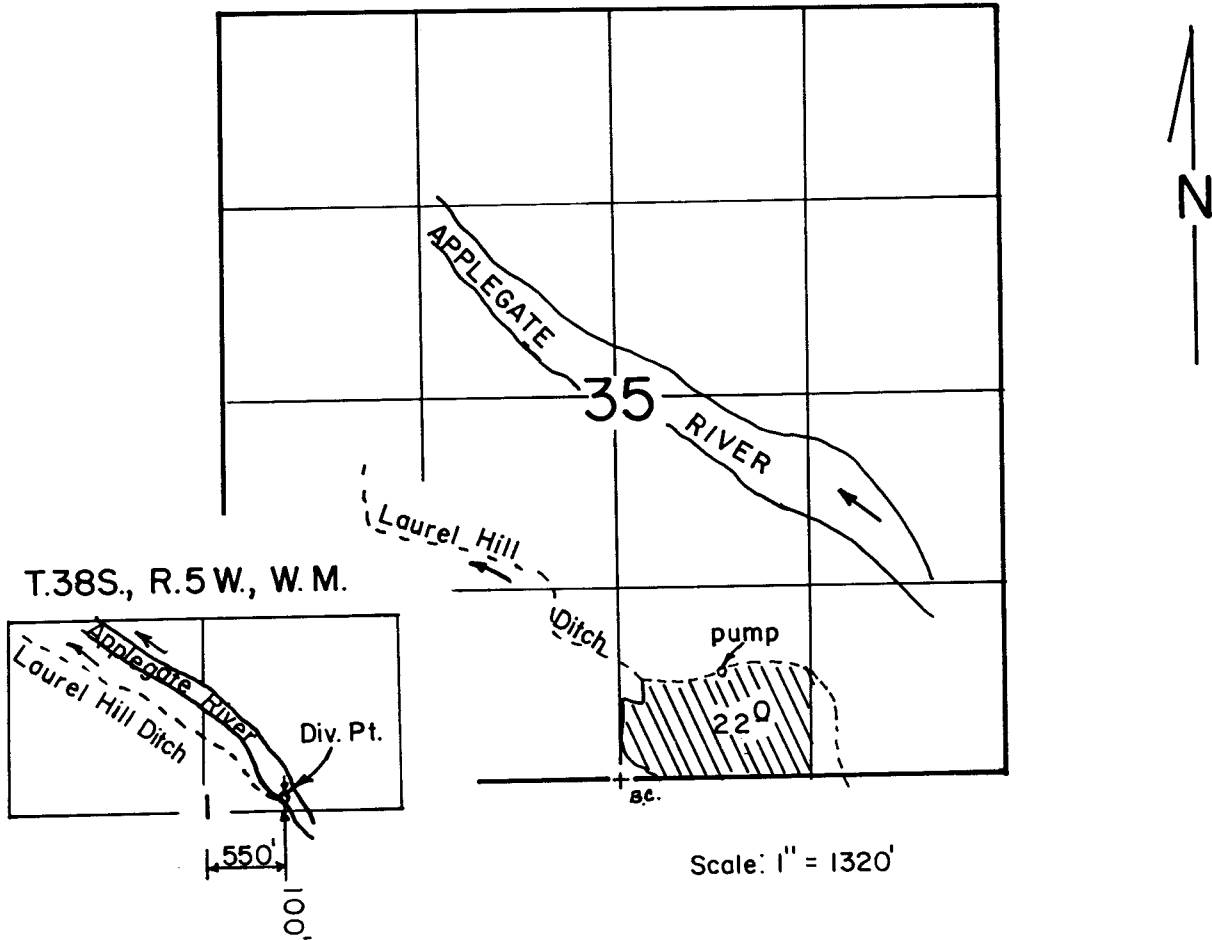

**FINAL PROOF SURVEY
UNDER**

Application No. 69060 Permit No. 50257....
IN NAME OF

...LON...or...CONNIE...YOUNG...

Surveyed N.O.V...7. 1991., by L...M...JOACHIMS

11033-129-110R
12/91
LMS