


Application No. 62630  
 Permit No. 50337  
 Malheur National Forest  
 Road Water  
 Scale: 2 inches = 1 mile  
 Diversion Locations: ✕  
 #1: NE 1/4 SW 1/4 Sec. 13 T. 18S. R. 34E.  
 #2: SW 1/4 NW 1/4 Sec. 5 T. 18S. R. 35E.  
 #3: NE 1/4 SW 1/4 Sec. 19 T. 19S. R. 34E.  
 Use Location: // // // //

**RECEIVED**  
 APR 20 1983  
 WATER RESOURCE DEPT.  
 SALEM, OREGON

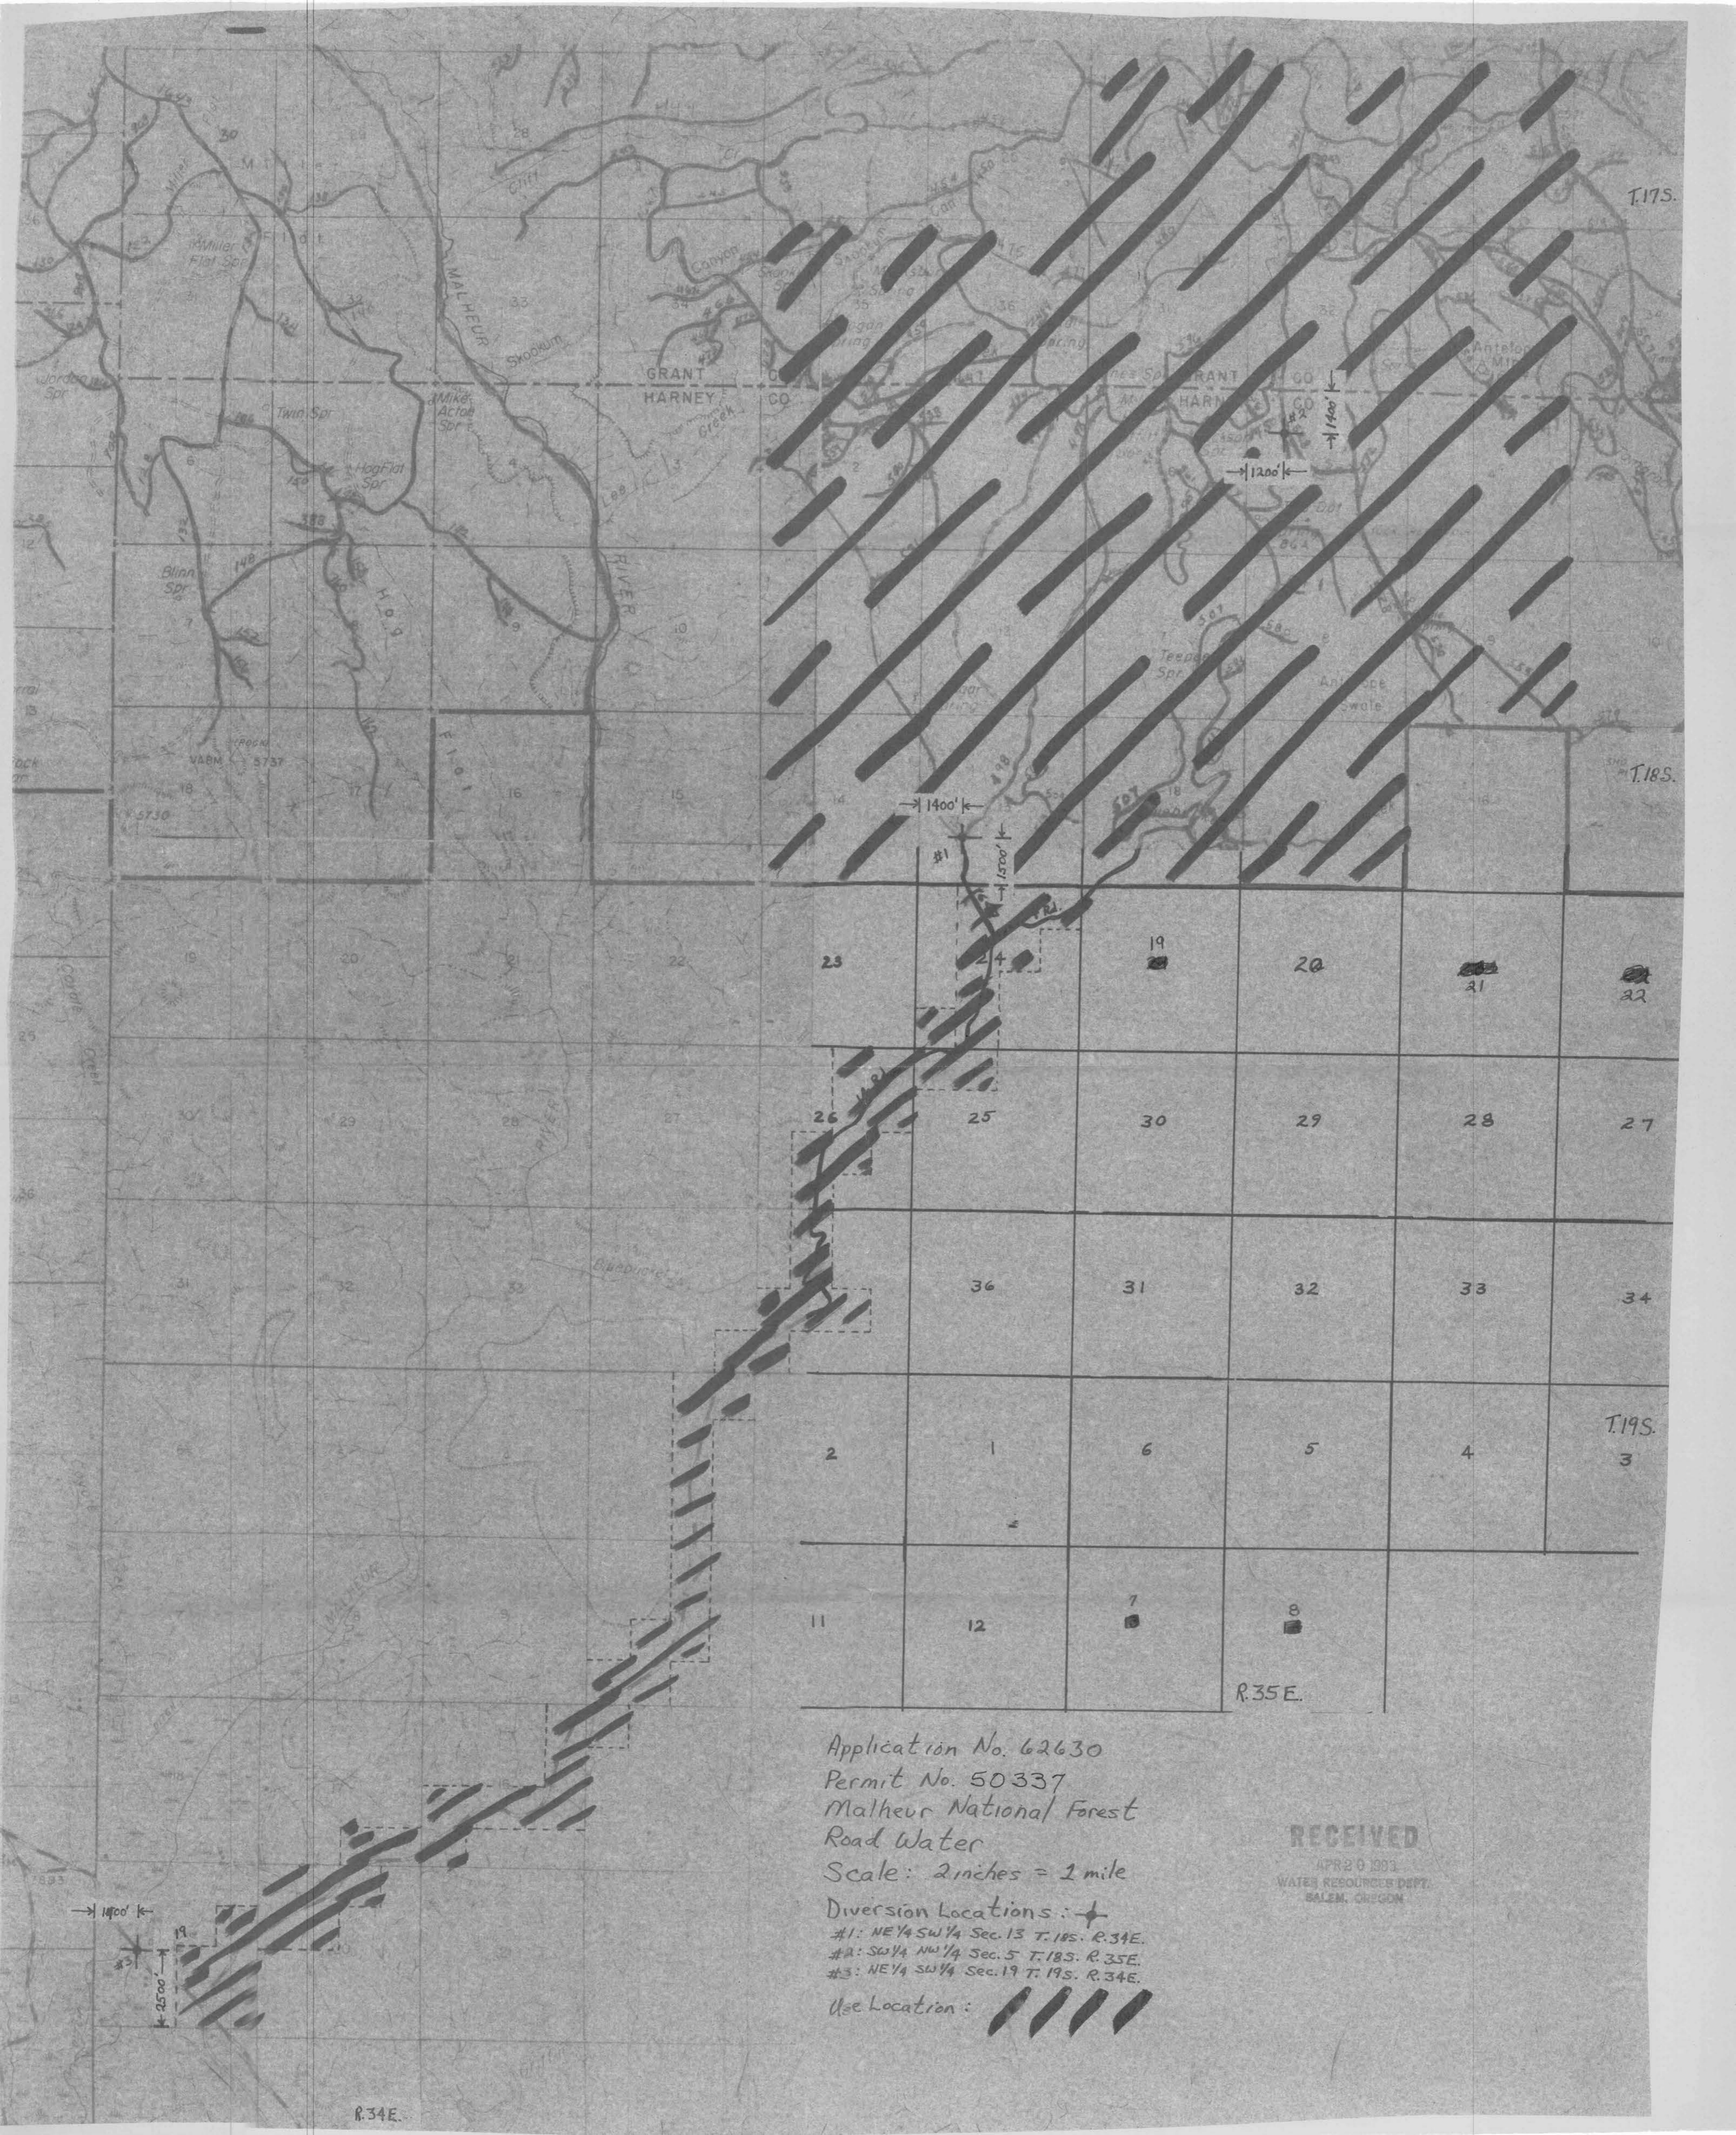

Application No. 62630  
 Permit No. 50337  
 Malheur National Forest  
 Road Water  
 Scale: 2 inches = 1 mile  
 Diversion Locations: +  
 #1: NE 1/4 SW 1/4 Sec. 13 T. 185. R. 34E.  
 #2: SW 1/4 NW 1/4 Sec. 5 T. 185. R. 35E.  
 #3: NE 1/4 SW 1/4 Sec. 19 T. 195. R. 34E.  
 Use Location: // // // //

**RECEIVED**  
 APR 20 1903  
 WATER RESOURCES DEPT.  
 SALEM, OREGON

R.34E.

R.35E.