


Township 38,

Range 2 W.

7037

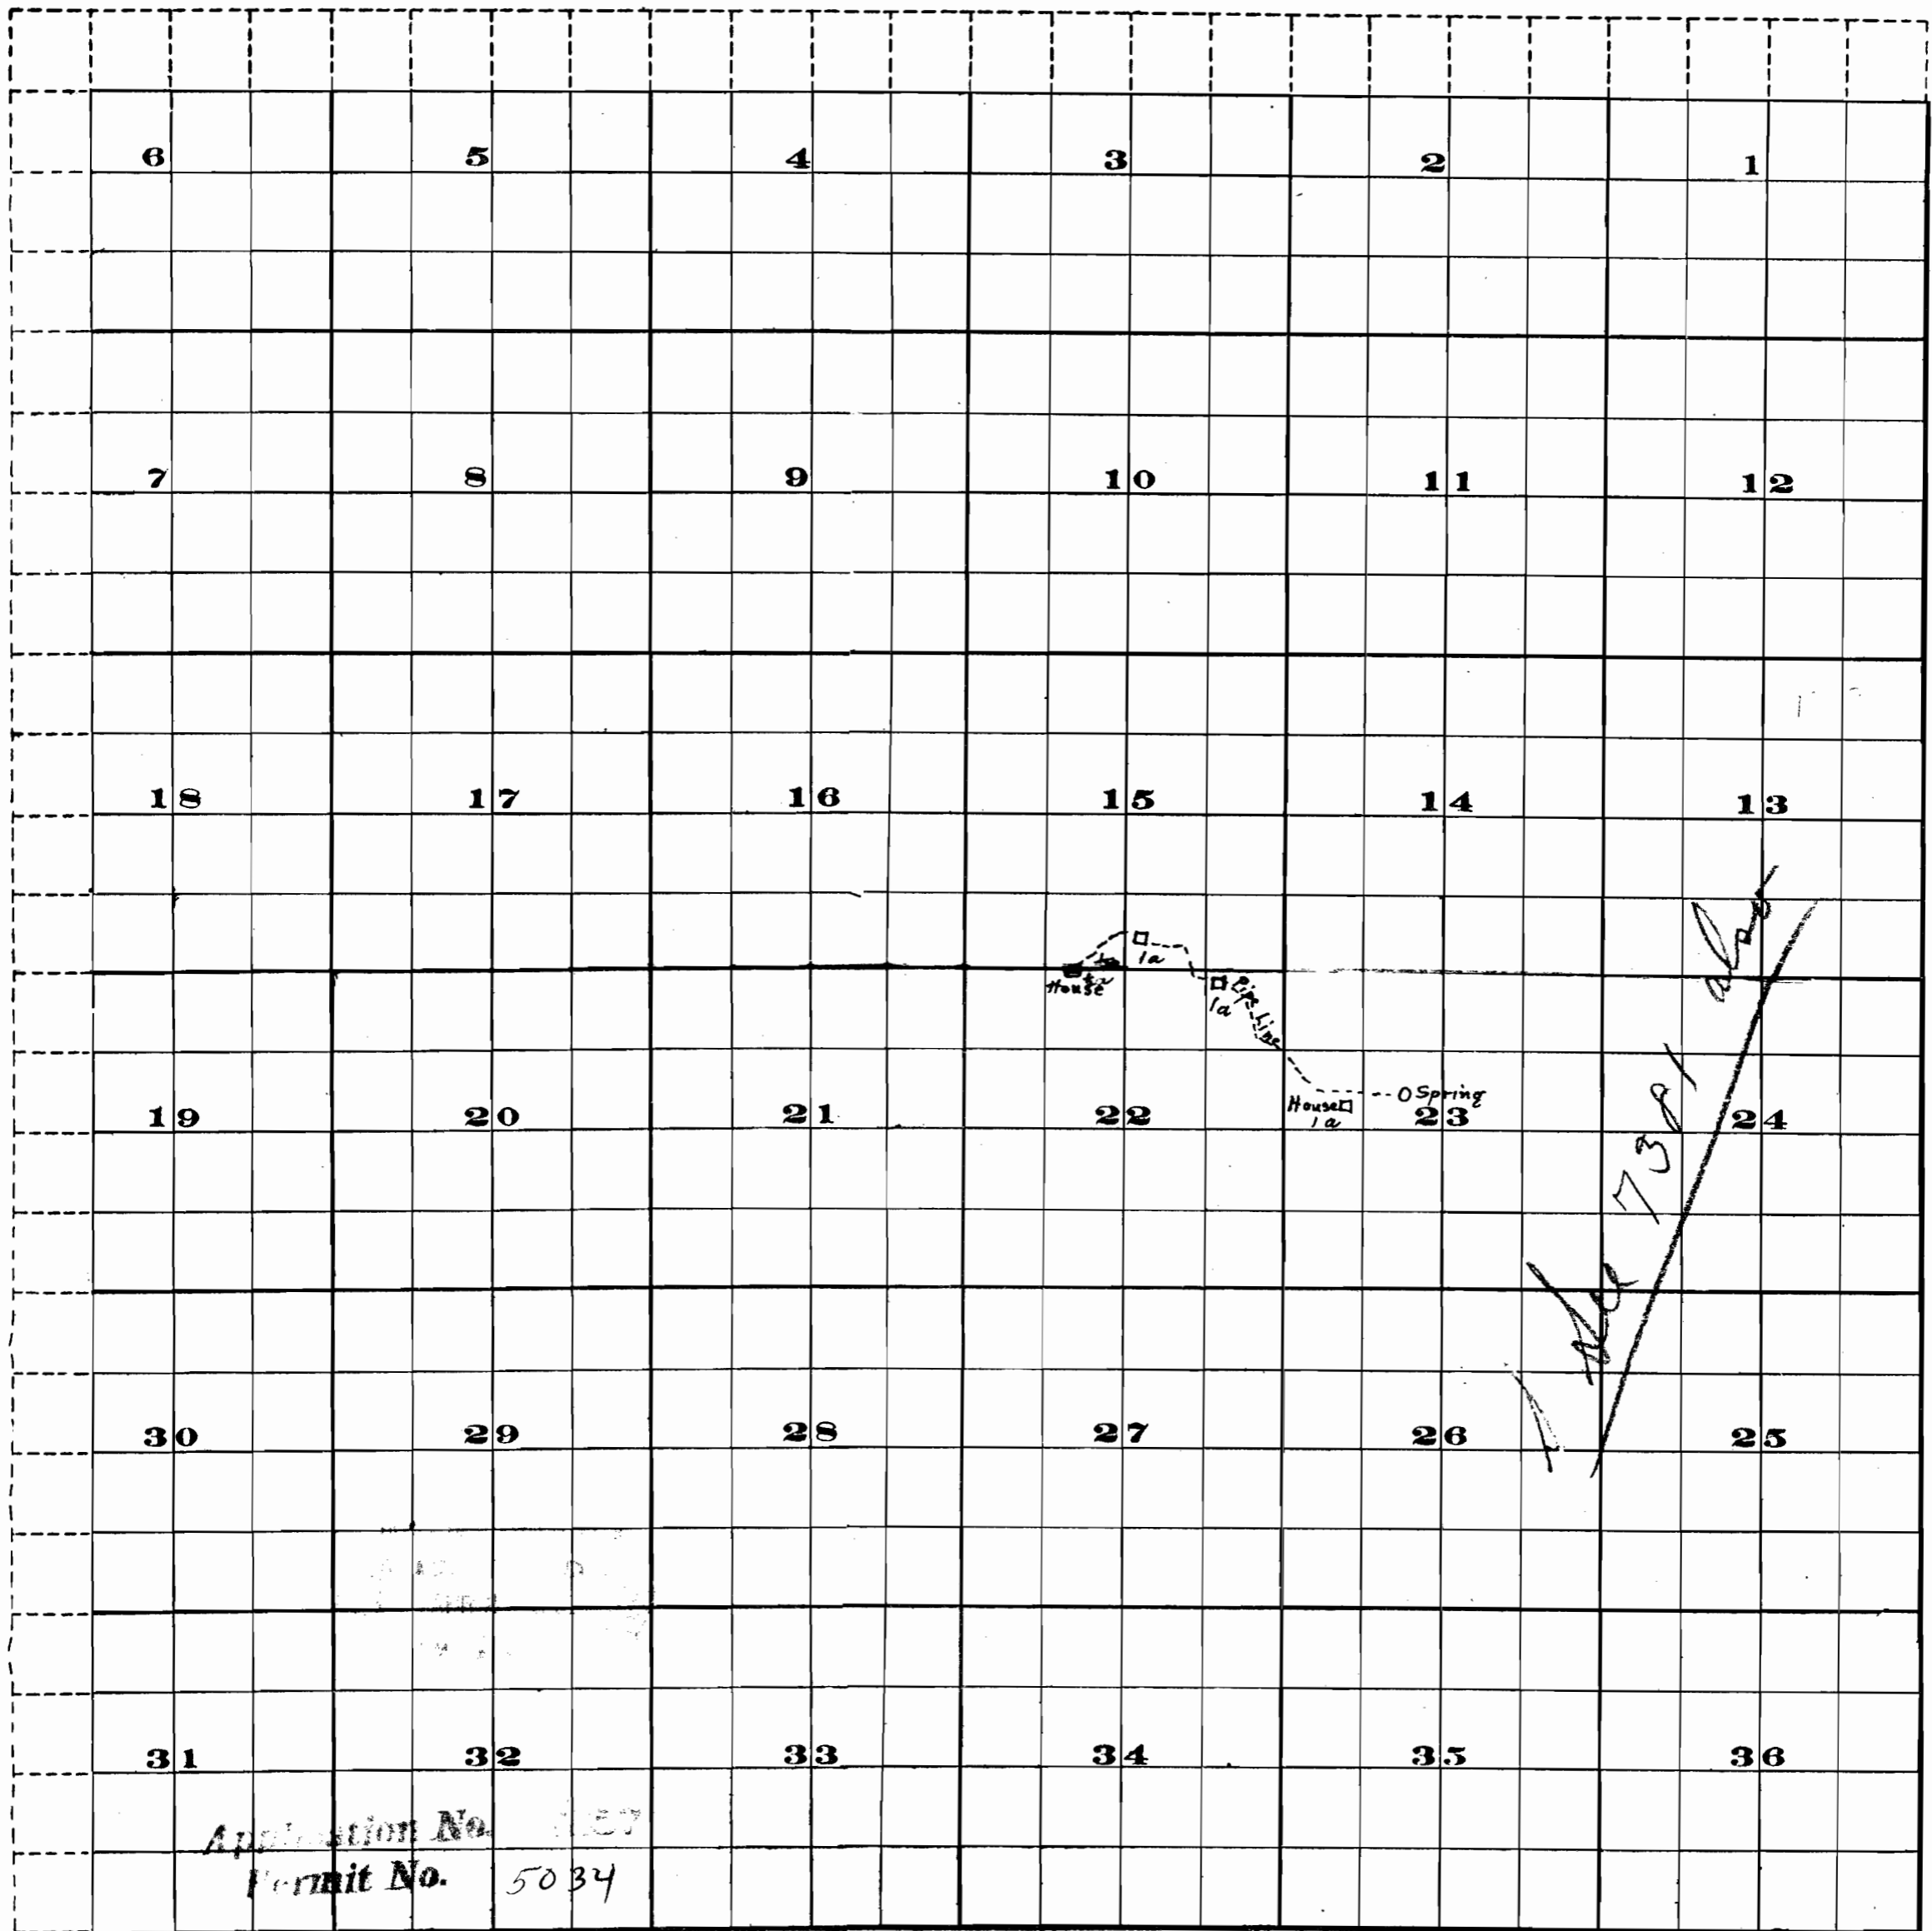

Scale of Feet.