

MALHEUR NATIONAL FOREST

STOCK WATER

BLUE BUCKET allotment

FS Temporary Id. #83P21


SCALE 4 IN. : 1 MILE

Map #1 of 2

North


application no. 67481

permit no. 50354

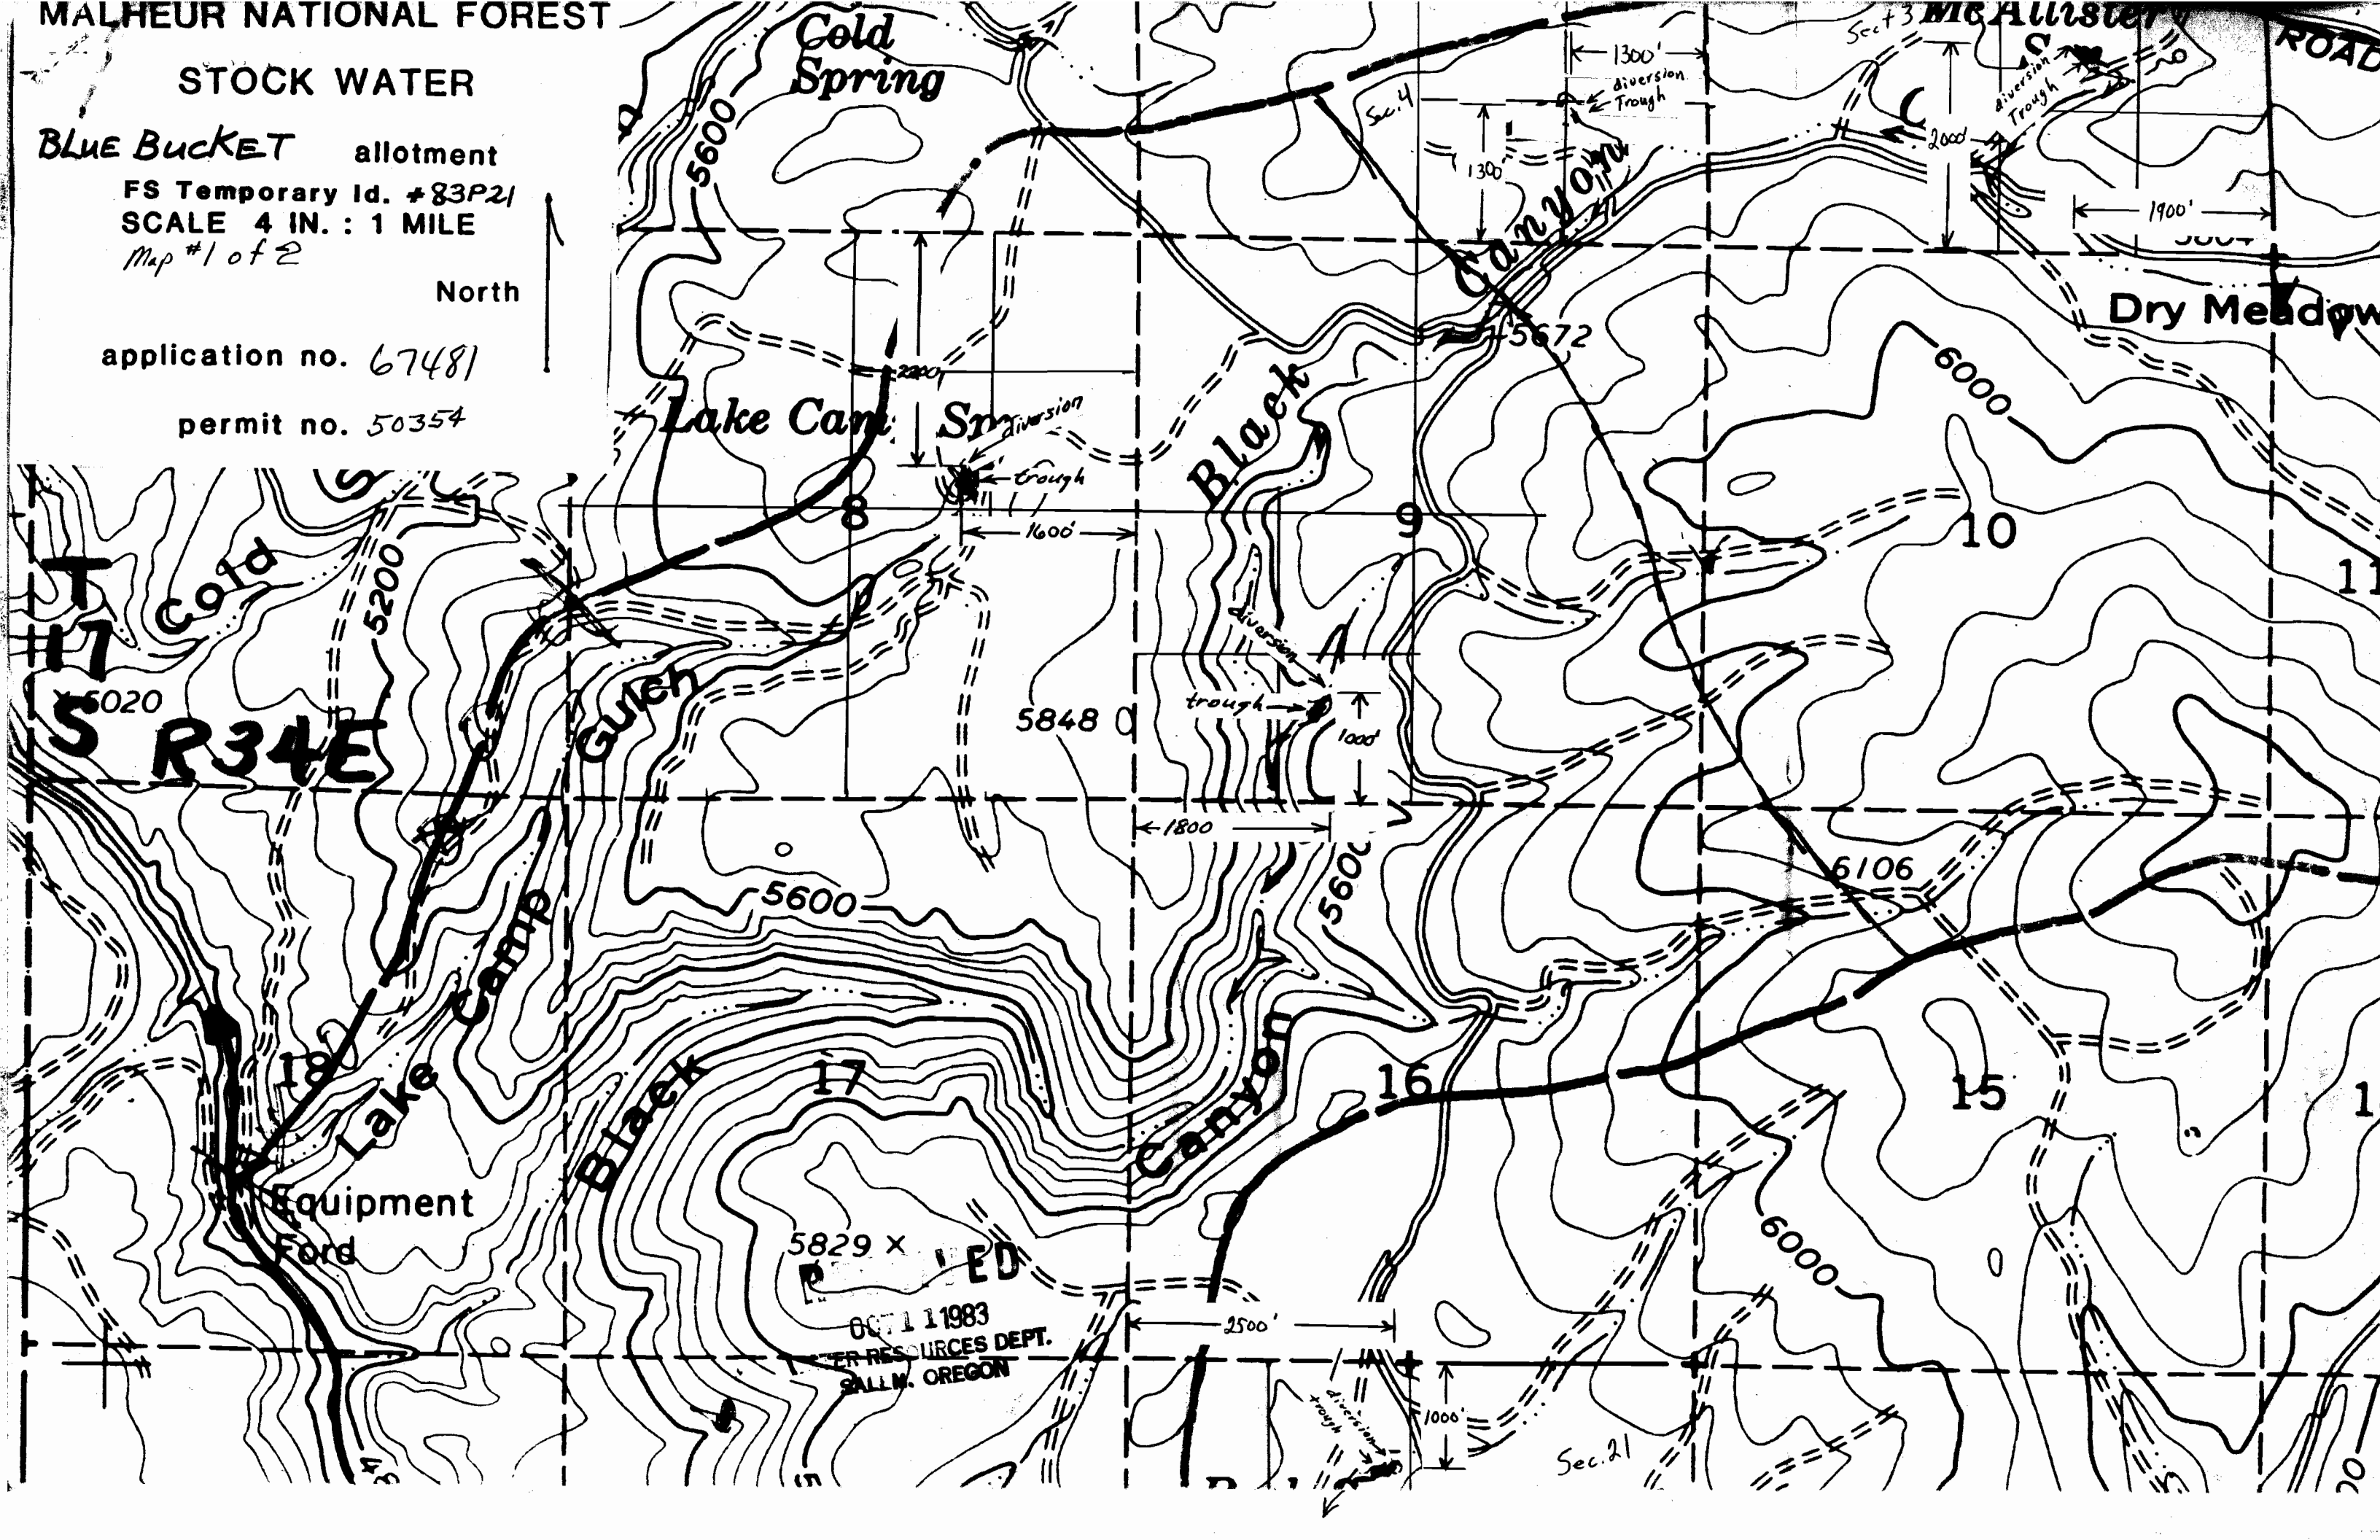

T 17 S R 34 E

00711 1983
WATER RESOURCES DEPT.
SALL M. OREGON

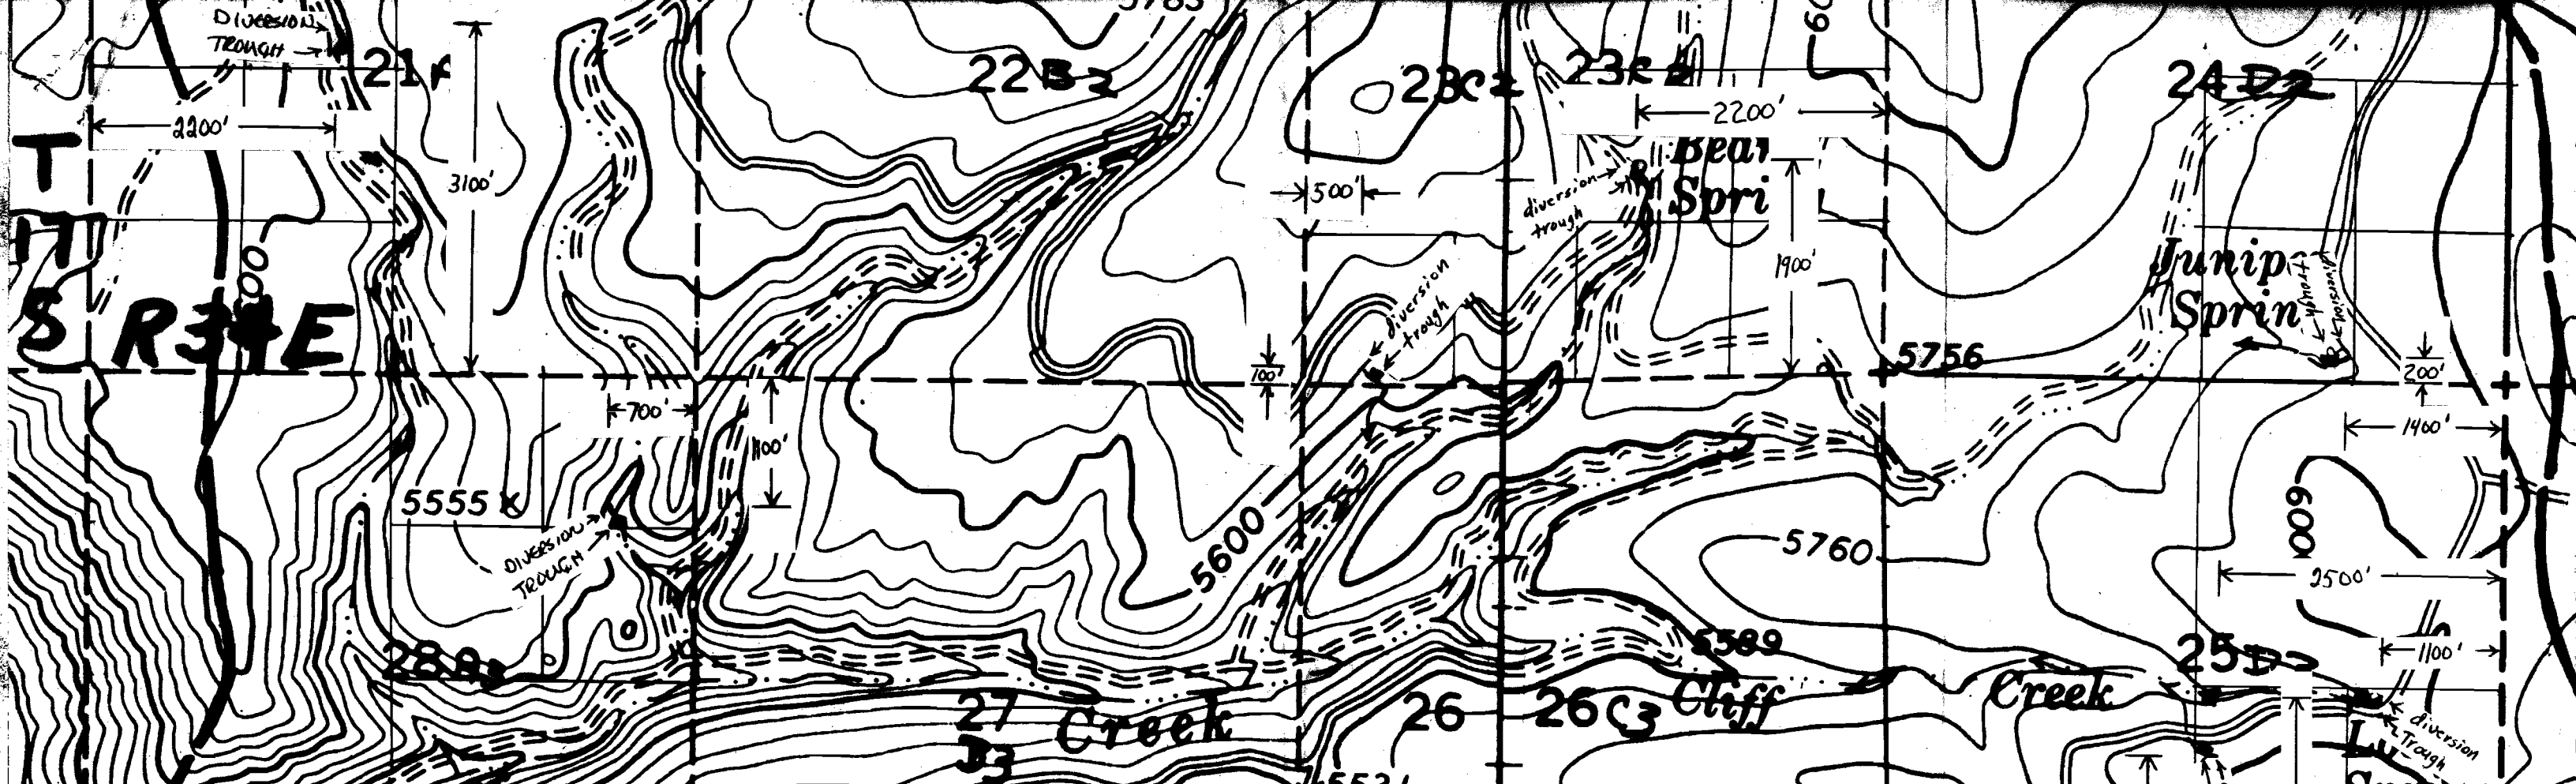

MALHEUR NATIONAL FOREST

STOCK WATER

BLUE BUCKET allotment

FS Temporary Id. #83P21

SCALE 4 IN. : 1 MILE

Map #2 of 2

North

application no. 67481

permit no. 50354

Canyon
3484

RECEIVED

OCT 11 1983

WATER RESOURCES DEPT.

SALMON, OREGON

GRANT CO

Can
5808

ksbury
35C4
Hogan Spring
5600

off m
ring

Westfall Spr

5200

AN