

SW1/4 SEC. 35, T. 35 S., R. 7 W., W.M.

1/4 Corner



T. 35 S. 34 35  
T. 36 S. 3 2

SW Corner of Section 35

ROAD

RIVERBANKS

SEE ENLARGED DETAIL (BELOW LEFT)

SUB.

BURNETTE DR.

2591'

BURNETTE



River

Rogue

1770'

1/4 Corner

**LEGEND:**

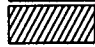-  PLACE OF USE (0.50 Acres)
-  POINT OF DIVERSION (1770' N & 2591' E of SW Cor. of Sec. 35)

**NOTE:**


TIES TO THE DIVERSION POINT ARE BASED UPON MEASUREMENTS MADE TO FOUND PROPERTY CORNERS AND WERE THEN COMPUTED FROM THE RECORD BEARING AND DISTANCE FROM THE INITIAL POINT OF "BURNETTE SUB." AND THE SW SEC. COR.

SURVEY TIES WERE MADE USING A WILD T-1600 THEOMAT AND A DISTOMAT DI-1000 E.D.M.I.

THIS PLAT WAS PREPARED FOR THE PURPOSE OF IDENTIFYING THE LOCATION OF THE WATER RIGHT FOR PERMIT NO. 50422. THERE IS NO INTENT TO PROVIDE DIMENSIONS OR LOCATIONS OF PROPERTY OWNERSHIP LINES.

A THREE PAGE SITE REPORT ACCOMPANIES THIS PLAT.

SUPPORTING DOCUMENTS:  
APPLICATION NO. G9666  
PERMIT NO. 50422

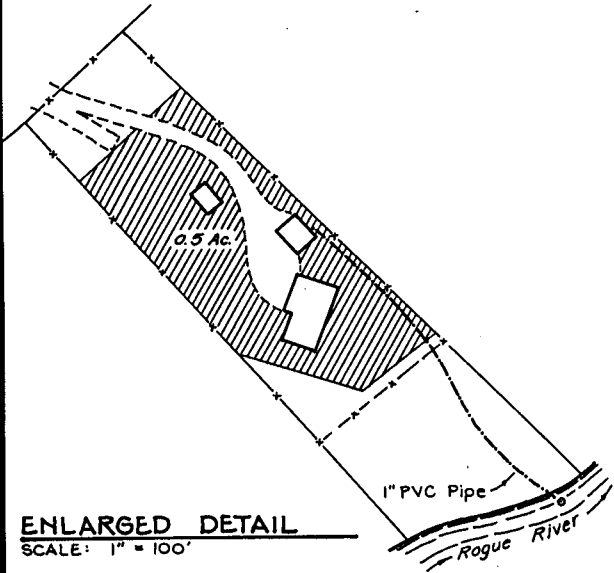


ENLARGED DETAIL  
SCALE: 1" = 100'

PROJECT NO.  
157-91-40

DRAWING NO.  
12 - 11.17

DATE  
Jan. 18, 1991

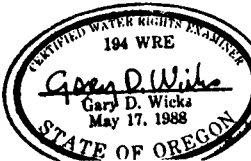

**PLAT OF CLAIM OF BENEFICIAL USE**

LOCATED IN LOT 4, BURNETTE SUBDIVISION

NE1/4 SW1/4 SEC. 35, T. 35 S., R. 7 W., W.M., JOSEPHINE COUNTY, OREGON

PREPARED FOR:  
MR. EDGAR A. STEINMEYER  
225 BURNETTE DRIVE

PREPARED BY:  
GARY D. WICKS, P.E., P.L.S.  
CIVIL ENGINEER & LAND SURVEYOR